

National Grid SA-COA **PRODUCTION FILE**

Contractor : ABB Contracting Co.

Project : SS 8709- 132/13.8kV in Alkhar

Contract No : 11131113/00

Substation : 8709

Subject : 132/13.8kV AVC Panel +AVC

ABB




POWER SYSTEMS NETWORK MANAGEMENT
PROTECTION AND SUBSTATION AUTOMATION SYSTEMS
WBS NO: S-13020


ABB AUTOMATION COMPANY LTD.,
414, AL-KHARJ ROAD
SECOND INDUSTRIAL CITY
RIYADH-11383 K.S.A


CONTRACTOR : ABB Contracting Company
CLIENT : National Gridsa
PROJECT : CONSTRUCTION OF NEW 132/13.8kv SS 8709 IN AL-KHARJ CITY
SUBSTATION : S/S 8709
CONTRACT NO. : 11131113/00
TITLE : Assembly Drawing – +AVC (GT1,GT2,GT3)

AS-BUILT BY		DATE	CONTRACT NO. 11131113/00	JOB ORDER NO. S-13020	COVER SHEET		الشركة الوطنية لنقل الكهرباء		نقل الكهرباء	
02	13 49	FACTORY ASBUILT	DRAWN BY RIZ CHECKED BY JKR		132/13.8KV (GT1,GT2,GT3) AVC PANEL		National Grid sa			
01	13 25	AS PER SEC COMMENT	DATE STARTED 04.02.2013 DATE COMPLETED		S/S 8709 - 132/13.8KV IN AL-KHARJ CITY		INDEX	PLANT NO.	DRAWING NUMBER	SHEET NO.
00	13 06	FOR APPROVAL	OPRG. DEPT. CTPD ENG. DEPT. AUT-PSAC		RIYADH SAUDI ARABIA		-	C421	CD-322935	000 001
REV. NO.	DATE	DESCRIPTION								REV. NO.

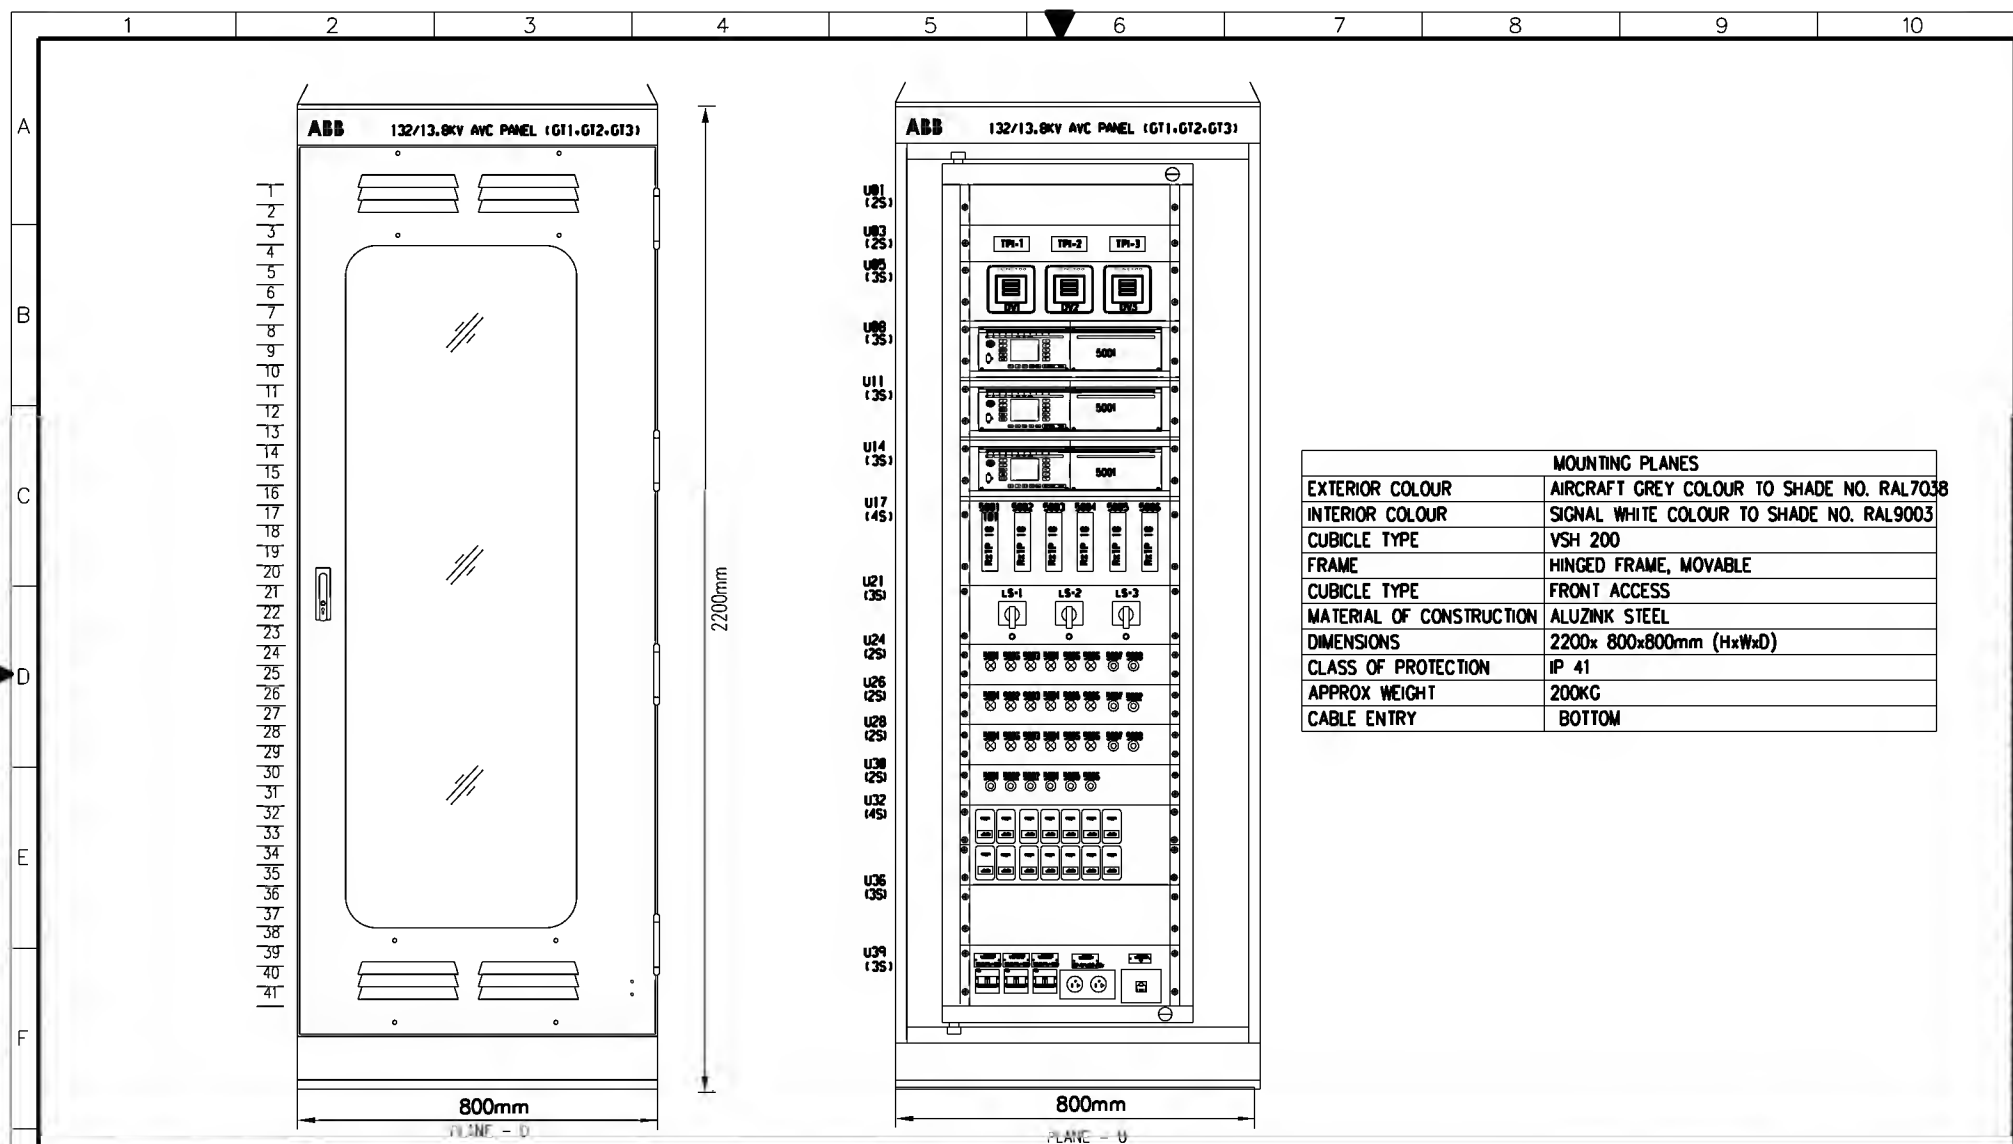

MOUNTING PLANES	
EXTERIOR COLOUR	AIRCRAFT GREY COLOUR TO SHADE NO. RAL7038
INTERIOR COLOUR	SIGNAL WHITE COLOUR TO SHADE NO. RAL9003
CUBICLE TYPE	VSH 200
FRAME	HINGED FRAME, MOVABLE
CUBICLE TYPE	FRONT ACCESS
MATERIAL OF CONSTRUCTION	ALUZINK STEEL
DIMENSIONS	2200x 800x800mm (HxWxD)
CLASS OF PROTECTION	IP 41
APPROX WEIGHT	200KG
CABLE ENTRY	BOTTOM

AS-BUILT BY _____ DATE _____			CONTRACT NO. 1113113/00		JOB ORDER NO. S-13020		ASSEMBLY DRAWING			الشركة الوطنية لنقل الكهرباء		 نقل الكهرباء National Grid sa				
02	13	49	FACTORY ASBUILT		DRAWN BY RIZ CHECKED BY JKR		132/13.8KV (GT1,GT2,GT3) AVC PANEL			INDEX		PLANT NO.	DRAWING NUMBER		SHEET NO.	REV. NO.
01	13	25	AS PER SEC COMMENT		DATE STARTED 04.02.2013 DATE COMPLETED _____		S/S 8709 - 132/13.8KV IN AL-KHARJ CITY			-		C421	CD-322935		SHT G01	CONT. G02
00	13	06	FOR APPROVAL		OPRG. DEPT. CTPD ENG. DEPT. AUT-PSAC		RIYADH SAUDI ARABIA								G01	G02
REV. NO.	DATE		DESCRIPTION													
																02

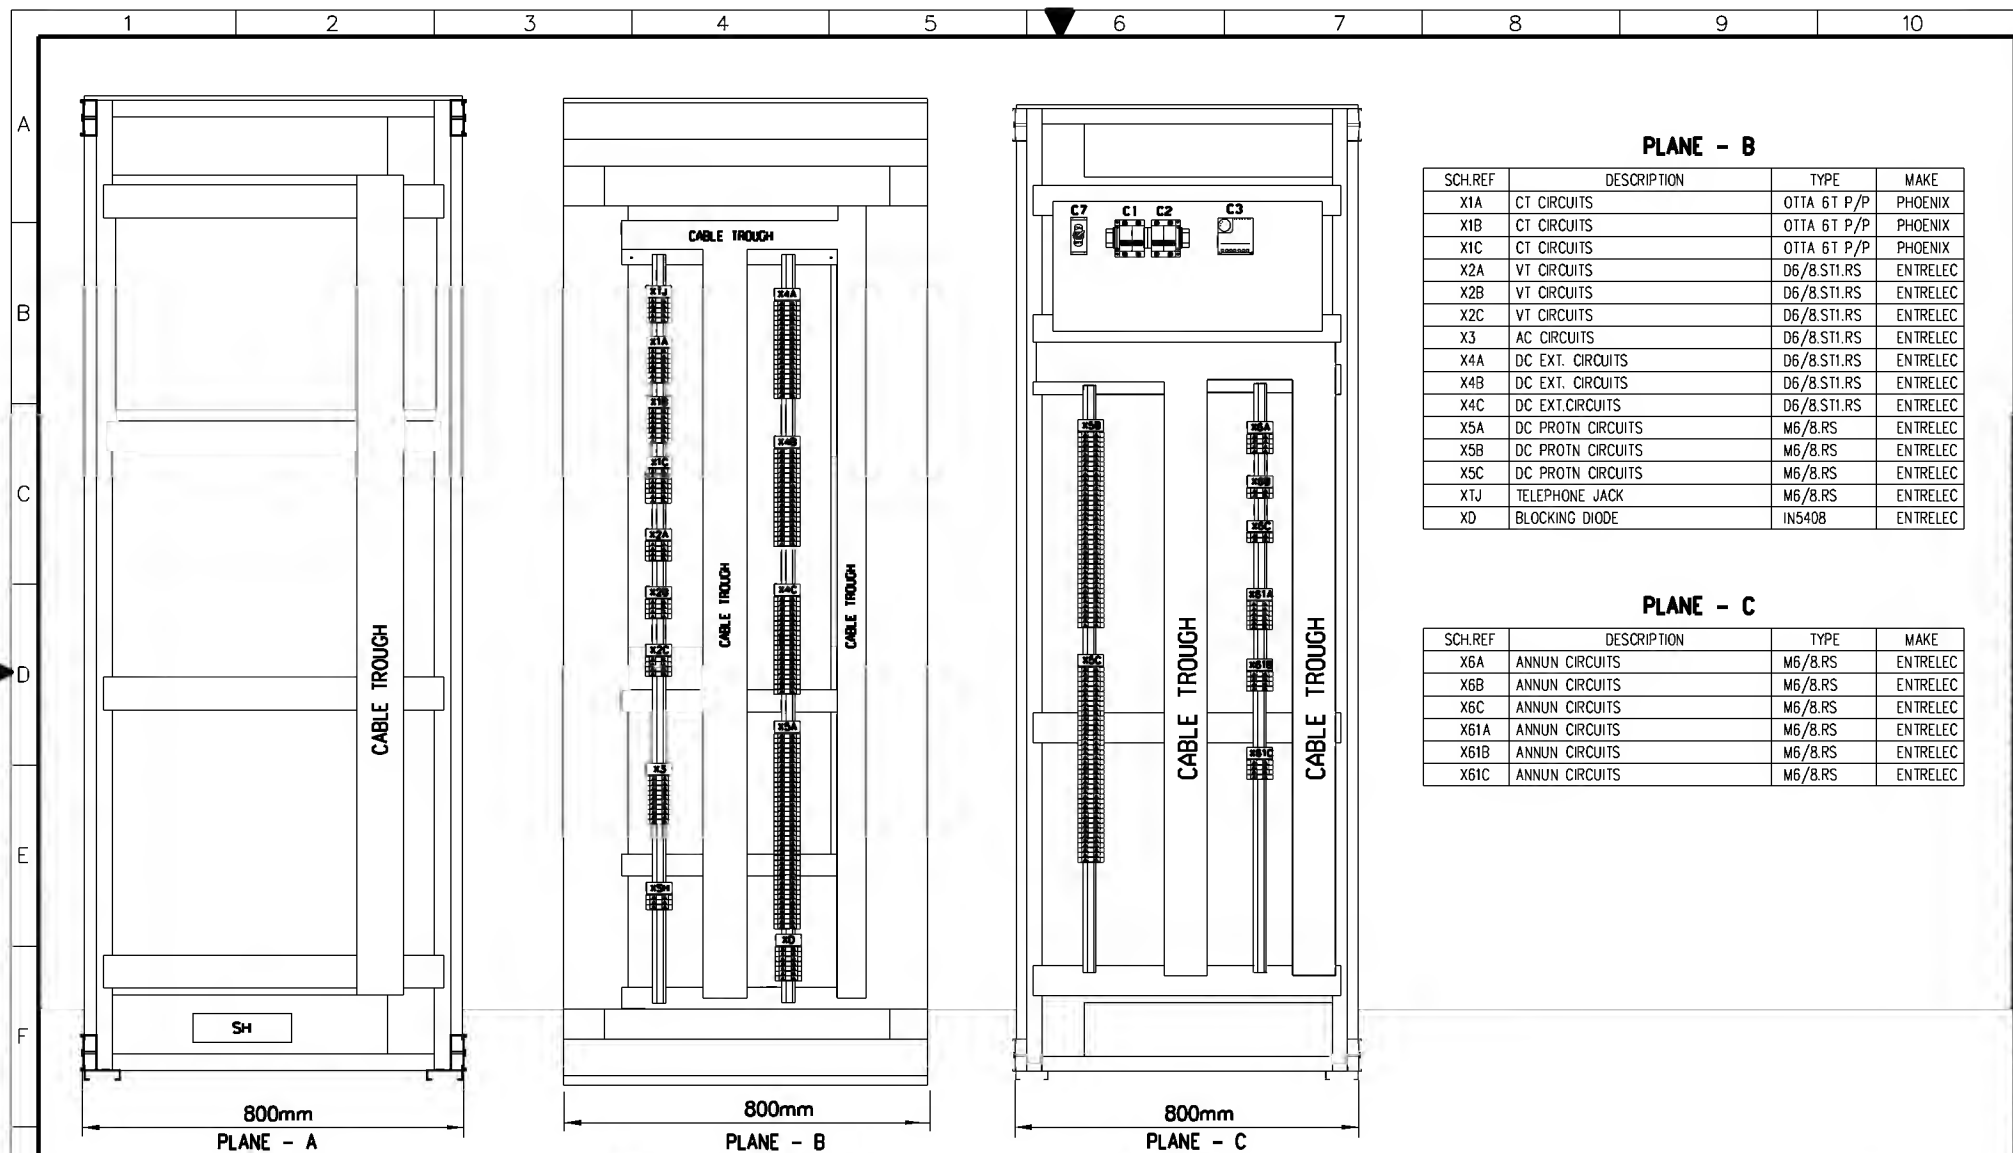

PLANE - B

SCH.REF	DESCRIPTION	TYPE	MAKE
X1A	CT CIRCUITS	OTTA 6T P/P	PHOENIX
X1B	CT CIRCUITS	OTTA 6T P/P	PHOENIX
X1C	CT CIRCUITS	OTTA 6T P/P	PHOENIX
X2A	VT CIRCUITS	D6/8.ST1.RS	ENTRELEC
X2B	VT CIRCUITS	D6/8.ST1.RS	ENTRELEC
X2C	VT CIRCUITS	D6/8.ST1.RS	ENTRELEC
X3	AC CIRCUITS	D6/8.ST1.RS	ENTRELEC
X4A	DC EXT. CIRCUITS	D6/8.ST1.RS	ENTRELEC
X4B	DC EXT. CIRCUITS	D6/8.ST1.RS	ENTRELEC
X4C	DC EXT. CIRCUITS	D6/8.ST1.RS	ENTRELEC
X5A	DC PROTN. CIRCUITS	M6/8.RS	ENTRELEC
X5B	DC PROTN. CIRCUITS	M6/8.RS	ENTRELEC
X5C	DC PROTN. CIRCUITS	M6/8.RS	ENTRELEC
XTJ	TELEPHONE JACK	M6/8.RS	ENTRELEC
XD	BLOCKING DIODE	IN5408	ENTRELEC

PLANE - C

SCH.REF	DESCRIPTION	TYPE	MAKE
X6A	ANNUN CIRCUITS	M6/8.RS	ENTRELEC
X6B	ANNUN CIRCUITS	M6/8.RS	ENTRELEC
X6C	ANNUN CIRCUITS	M6/8.RS	ENTRELEC
X61A	ANNUN CIRCUITS	M6/8.RS	ENTRELEC
X61B	ANNUN CIRCUITS	M6/8.RS	ENTRELEC
X61C	ANNUN CIRCUITS	M6/8.RS	ENTRELEC

AS-BUILT BY _____ DATE _____ CONTRACT NO. 11131113/00 JOB ORDER NO. S-13020

02	13 49	FACTORY ASBUILT
01	13 25	AS PER SEC COMMENT
00	13 06	FOR APPROVAL
REV. NO.	DATE	DESCRIPTION

DRAWN BY RIZ	CHECKED BY JKR
DATE STARTED 04.02.2013	DATE COMPLETED
PRG. DEPT. CTPD	ENG. DEPT. AUT-PSAC


ASSEMBLY DRAWING

132/13.8KV (GT1,GT2,GT3) AVC PANEL
S/S 8709 - 132/13.8KV IN AL-KHARJ CITY
RIYADH SAUDI ARABIA

الشركة الوطنية لنقل الكهرباء



INDEX	PLANT NO.	DRAWING NUMBER	SHEET NO.	REV. NO.
-	C421	CD-322935	G02 G03	02

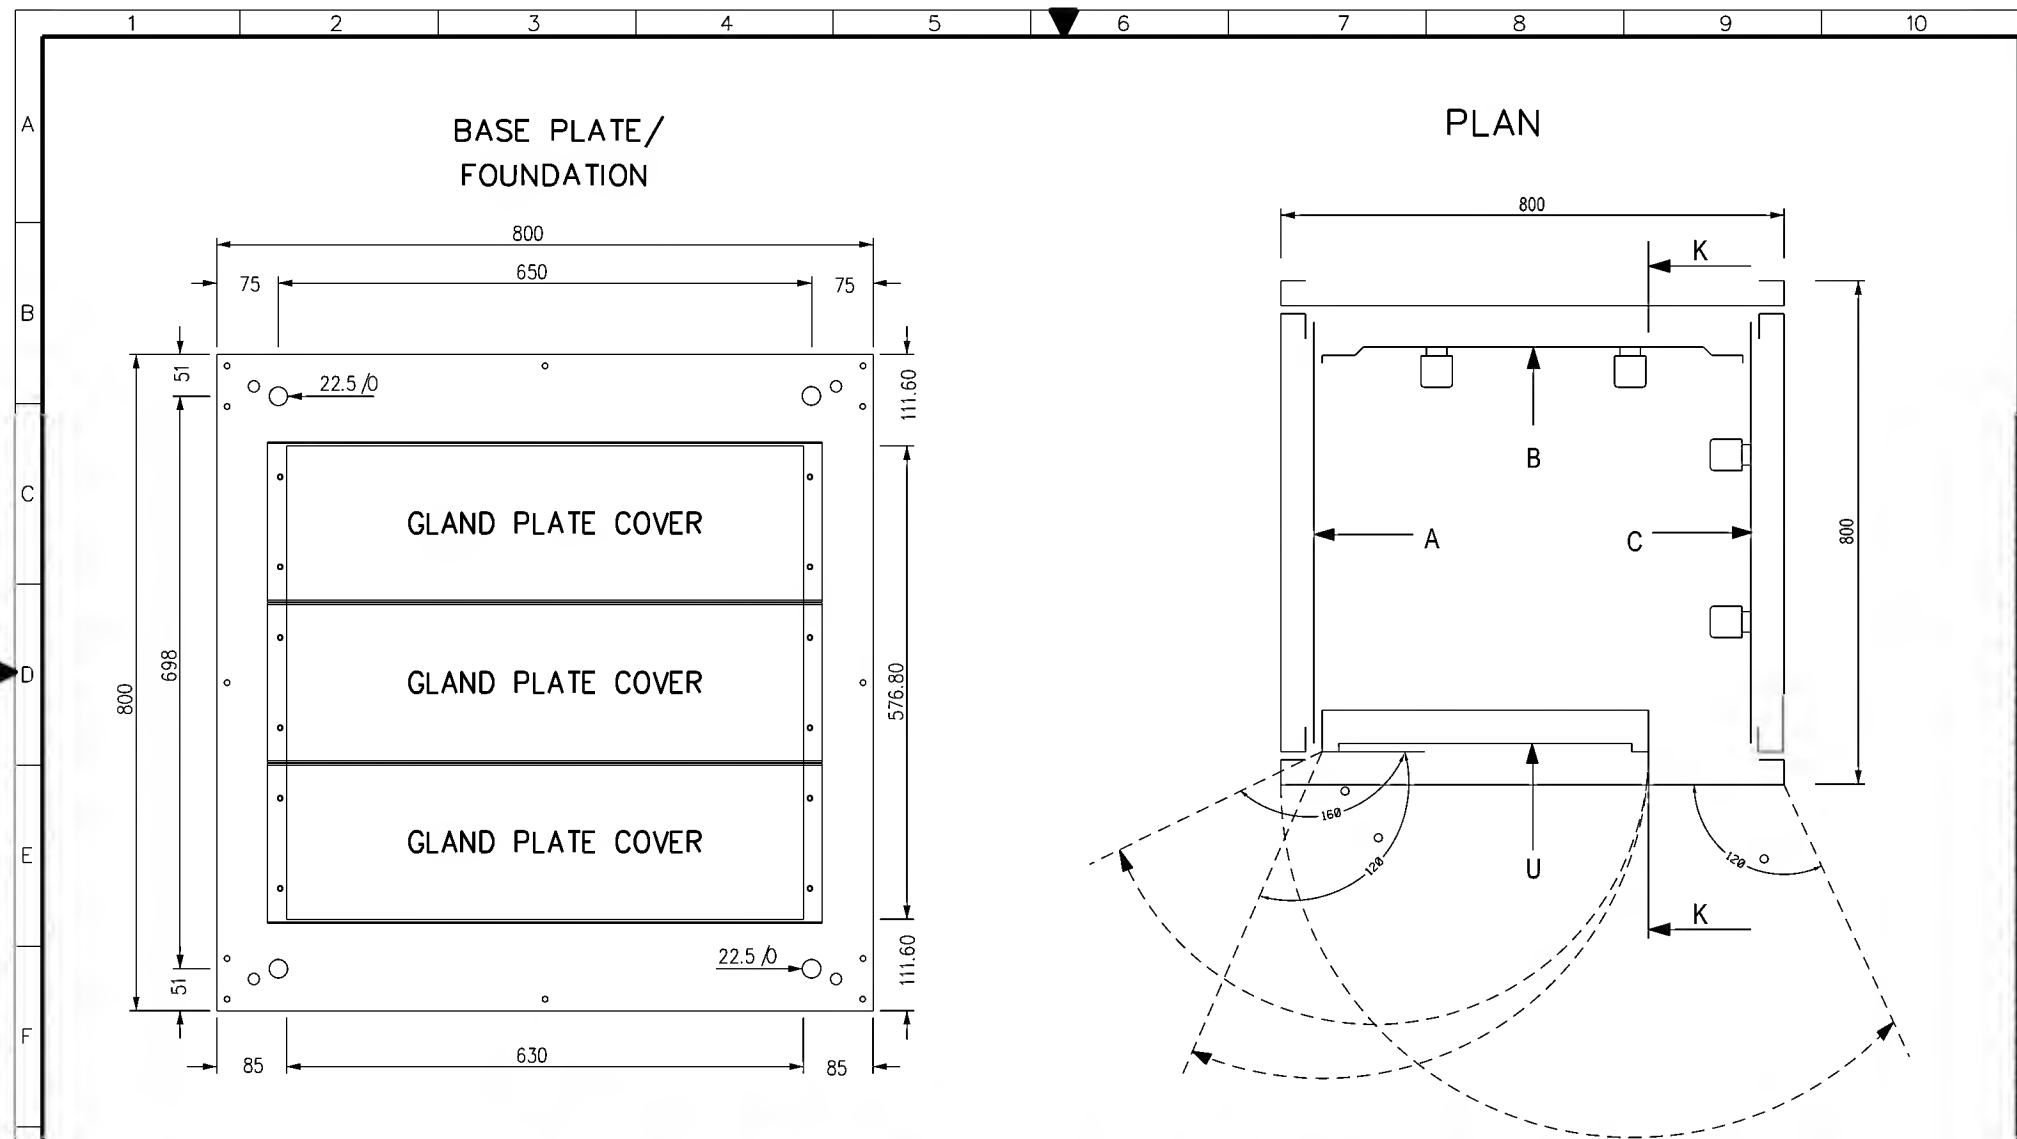

AS-BUILT BY _____ DATE _____ CONTRACT NO. **11131113/00** JOB ORDER NO. **S-13020**

02	13 49	FACTORY ASBUILT
01	13 25	AS PER SEC COMMENT
00	13 06	FOR APPROVAL
REV. NO.	DATE	DESCRIPTION

DRAWN BY RIZ	CHECKED BY JKR
DATE STARTED 04.02.2013	DATE COMPLETED _____
OPRG. DEPT. CTPD	ENG. DEPT. AUT-PSAC

ASSEMBLY DRAWING
132/13.8KV (GT1,GT2,GT3) AVC PANEL
S/S 8709 - 132/13.8KV IN AL-KHARJ CITY
RIYADH SAUDI ARABIA


الشركة الوطنية لنقل الكهرباء					نقل الكهرباء National Grid SA	
INDEX	PLANT NO.	DRAWING NUMBER		SHEET NO.	REV. NO.	
-	C421	CD-322935		G03 G04	02	

THIS DRAWING AND THE INFORMATION CONTAINED HEREIN ARE THE SOLE PROPERTY OF NATIONAL GRID SAUDI ARABIA. NO REPRODUCTION OR TRANSMISSION IN ANY FORM OR BY ANY MEANS, WITHOUT THE WRITTEN CONSENT OF NATIONAL GRID SAUDI ARABIA, IS PERMITTED.




TOP VIEW FOR EARTHING BAR

U PLANE TOP LABEL

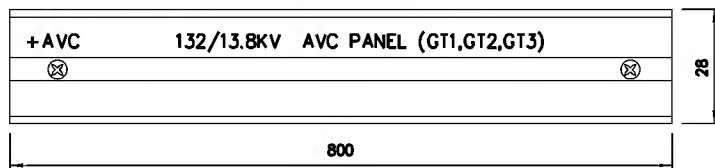

U PLANE BOTTOM LABEL

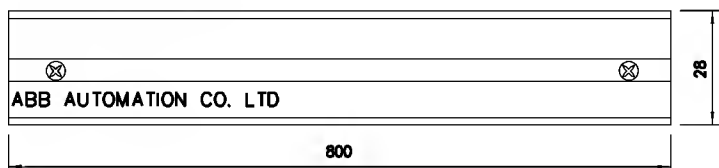

MANUFACTURED LABEL

ABB ABB Automation Co.Ltd.	
PROJECT :	National Grid SA S/S 8709
ORDER REFERENCE :	2875 RF S13020
YEAR OF MANUFACTURE:	2013
PANEL NO. :	+AVC
DRAWING NO. :	S13020-CD-322936
SPECIFICATION :	31-TMSS-01,REV.0
MADE IN THE KINGDOM OF SAUDI ARABIA	

AS-BUILT BY _____ DATE _____ CONTRACT NO. **11131113/00** JOB ORDER NO. **S-13020**

02	13 49	FACTORY ASBUILT
01	13 25	AS PER SEC COMMENT
00	13 06	FOR APPROVAL
REV. NO.	DATE	DESCRIPTION

DRAWN BY **RIZ** CHECKED BY **JKR**
DATE STARTED **04.02.2013** DATE COMPLETED _____
OPRG. DEPT. **CTPD** ENG. DEPT. **AUT-PSAC**

ASSEMBLY DRAWING

132/13.8KV (GT1,GT2,GT3) AVC PANEL
S/S 8709 - 132/13.8KV IN AL-KHARJ CITY
RIYADH SAUDI ARABIA

الشركة الوطنية لنقل الكهرباء



نقل الكهرباء
National Grid sa

INDEX	PLANT NO.	DRAWING NUMBER	SHEET NO.	REV. NO.
-	C421	CD-322935	SHT 04 CONT. L00	02



POWER SYSTEMS NETWORK MANAGEMENT
PROTECTION AND SUBSTATION AUTOMATION SYSTEMS
WBS NO: S-13020

ABB AUTOMATION COMPANY LTD.
414, AL-KHARJ ROAD
SECOND INDUSTRIAL CITY
RIYADH-11383 K.S.A

CONTRACTOR : ABB Contracting Company
CLIENT : National Gridsa
PROJECT : CONSTRUCTION OF NEW 132/13.8kV SS 8709 IN AL-KHARJ CITY
SUBSTATION : S/S 8709
CONTRACT NO. : 11131113/00
TITLE : LIST OF APPARATUS + AVC (GT1,GT2,GT3)

AS-BUILT BY		DATE	CONTRACT NO. 11131113/00	JOB ORDER NO. S-13020	COVER SHEET		الشركة الوطنية لنقل الكهرباء		نقل الكهرباء	
02	13 49	FACTORY ASBUILT	DRAWN BY RIZ CHECKED BY JKR		132/13.8KV (GT1,GT2,GT3) AVC PANEL		National Grid sa			
01	13 25	AS PER SEC COMMENT	DATE STARTED 04.02.2013 DATE COMPLETED		S/S 8709 - 132/13.8KV IN AL-KHARJ CITY		INDEX	PLANT NO.	DRAWING NUMBER	SHEET NO.
00	13 06	FOR APPROVAL	OPRG. DEPT. CTPD ENG. DEPT. AUT-PSAC		RIYADH SAUDI ARABIA		-	C421	CD-322935	02
REV. NO.	DATE	DESCRIPTION								

	1	2	3	4	5	6	7	8	9	10
A	SR. NO.	GA. REF.	SCH. REF.	D E S C R I P T I O N		SHEET. NO.	QTY.	TYPE	MAKE	ORDERING INFORMATION
				PANEL +AVC ACCOMMODATING THE FOLLOWING:						
	1	U03.5001	TPI-1	TAP POSITION INDICATOR (19 TAPS)		221	3		FAGET	* SUPPLIED BY
		U03.5002	TPI-2	INPUT : 4-20mA		222				TRAFO MAF.
		U03.5003	TPI-3	AUX.VOLTAGE : 127V DC		223				
B	2	U05.5001	DV1	DIGITAL MULTIFUNCTION METER		221	3	ION6200	SCHNEIDER	M6200 A0 A000A0A0R
		U05.5002	DV2	PT RATIO : 0-120V (13.8KV/3/120/3)		222				+P620 PB
		U05.5003	DV3	FREQUENCY : 45 TO 65 HZ		223				
				ACCURACY CLASS : 0.2						
				AUX.VOLTAGE : 100-300V DC						
C	3	U08.5001	90-1	AUTOMATIC VOLTAGE REGULATING RELAY		498	3	TAPCON 260	MR	TAPCON 260
		U11.5001	90-2	VOLTAGE LEVEL SETTING : 85V TO 140V OF Un IN STEPS OF 0.1V,						
		U14.5001	90-3	BANDWIDTH : 0.5-9% Un IN STEPS 0.01%						
				O/C BLOCKING 50 TO 210 %						
				U/V BLOCKING - 60 TO 100%						
				O/V DECTION - 100 TO 140%						
D	4	U17.5001	TS-1	TEST SWITCH FOR AVC RELAY		221	6	RTXPI8	ABB	RK 926 115-AD
		U17.5002	TS-2			222				
		U17.5003	TS-3			223				
		U17.5004	TS-DV1	TEST SWITCH FOR DIGITALVOLTMETER		221				
		U17.5005	TS-DV2			222				
		U17.5006	TS-DV3			223				
E	5	U21.5001	LS-1	SELECTOR SWITCH FOR AVC LOCAL-SUPERVISORY		235	3	R20 2/4	COMELECTRIC	R193L-204_27-07
		U21.5002	LS-2	2 POSITION, 4 STACKS		335				
		U21.5003	LS-3			435				
F	6	U24.5001	L01	INDICATION LAMP FOR AVC IN LOCAL		233	3	ML1-100R	ABB	1SFA 611 400 R1001
		U26.5001	L07	LENS :RED		333		MCBH-003		1SFA 611 605 R1400
		U28.5001	L13	LED RATING :110-130V,4-6mA		433		KA2 2141		1SFA 616 921 R2141

AS-BUILT BY		DATE	CONTRACT NO. 1113113/00	JOB ORDER NO. S-13020	LIST OF APPARATUS		الشركة الوطنية لنقل الكهرباء		نقل الكهرباء	
02	13 49	FACTORY ASBUILT	DRAWN BY RIZ	CHECKED BY JKR	132/13.8KV (GT1,GT2,GT3) AVC PANEL		National Grid sa			
01	13 25	AS PER SEC COMMENT	DATE STARTED 04.02.2013	DATE COMPLETED	S/S 8709 - 132/13.8KV IN AL-KHARJ CITY		INDEX	PLANT NO.	DRAWING NUMBER	SHEET NO.
00	13 06	FOR APPROVAL	OPRG. DEPT. CTPD	ENG. DEPT. AUT-PSAC	RIYADH SAUDI ARABIA		-	C421	CD-322935	02
REV. NO.	DATE	DESCRIPTION								

	1	2	3	4	5	6	7	8	9	10
A	SR. NO.	GA. REF.	SCH. REF.	D E S C R I P T I O N		SHEET. NO.	QTY.	TYPE	MAKE	ORDERING INFORMATION
	7	U24.5002	L02	INDICATION LAMP FOR AVC IN SUPERVISORY		233	3	ML1-100Y	ABB	1SFA 611 400 R1001
		U26.5002	L08	LENS :YELLOW		333		MCBH-003		1SFA 611 605 R1400
		U28.5002	L14	LED RATING :110-130V,4-6mA		433		KA2 2143		1SFA 616 921 R2143
B	8	U24.5003	L03	INDICATION LAMP FOR OL TC OUT OF STEP		233	3	ML1-100B	ABB	1SFA 611 400 R1001
		U26.5003	L09	LENS :BLUE		333		MCBH-003		1SFA 611 605 R1400
		U28.5003	L15	LED RATING :110-130V,4-6mA		433		KA2 2144		1SFA 616 921 R2144
C	9	U24.5004	L04	INDICATION LAMP FOR OL TC TAP CHANGER IN PROGRESS		233	3	ML1-100R	ABB	1SFA 611 400 R1001
		U26.5004	L10	LENS :RED		333		MCBH-003		1SFA 611 605 R1400
		U28.5004	L16	LED RATING :110-130V,4-6mA		433		KA2 2141		1SFA 616 921 R2141
D	10	U24.5005	L05	INDICATION LAMP FOR AUTO		233	3	ML1-100Y	ABB	1SFA 611 400 R1001
		U26.5005	L11	LENS :YELLOW		333		MCBH-003		1SFA 611 605 R1400
		U28.5005	L17	LED RATING :110-130V,4-6mA		433		KA2 2143		1SFA 616 921 R2143
E	11	U24.5006	L06	INDICATION LAMP FOR MANUAL		233	3	ML1-100R	ABB	1SFA 611 400 R1001
		U26.5006	L12	LENS :RED		333		MCBH-003		1SFA 611 605 R1400
		U28.5006	L18	LED RATING :110-130V,4-6mA		433		KA2 2144		1SFA 616 921 R2144
F	12	U24.5007	PB1	PUSH BUTTON FOR OLTC RAISE		235	3	MP1-10B	ABB	1SFA 611 100 R1006
		U26.5007	PB3	BUTTON COLOUR :BLACK		335		MCBH-11		1SFA 611 605 R1111
		U28.5007	PB5	CONTACT DATA :1NO + 1NC		435				
	13	U24.5008	PB2	PUSH BUTTON FOR OLTC LOWER		235	3	MP1-10B	ABB	1SFA 611 100 R1006
		U26.5008	PB4	BUTTON COLOUR :BLACK		335		MCBH-11		1SFA 611 605 R1111
		U28.5008	PB6	CONTACT DATA :1NO + 1NC		435				
	14	U30.5001	PBES-1	PUSH BUTTON FOR EMERGENCY STOP		237	3	MP1-10B	ABB	1SFA 611 100 R1006
		U30.5003	PBES-2	BUTTON COLOUR :BLACK		337		MCBH-11		1SFA 611 605 R1111
		U30.5005	PBES-3	CONTACT DATA :1NO + 1NC		437				
	15	U30.5002	LT1	LAMP TEST BUSH BUTTON		236	3	MP1-10B	ABB	1SFA 611 100 R1006
		U30.5004	LT2	AUX VOLTAGE :110V-125V DC		336		MCBH-11		1SFA 611 605 R1111
		U30.5006	LT3	CONTACT DATA :1NO+1NC		436				

AS-BUILT BY		DATE	CONTRACT NO. 11131113/00	JOB ORDER NO. S-13020	LIST OF APPARATUS		الشركة الوطنية لنقل الكهرباء		نقل الكهرباء	
02	13 49	FACTORY ASBUILT	DRAWN BY RIZ	CHECKED BY JKR	132/13.8KV (GT1,GT2,GT3) AVC PANEL		National Grid sa			
01	13 25	AS PER SEC COMMENT	DATE STARTED 04.02.2013	DATE COMPLETED	S/S 8709 - 132/13.8KV IN AL-KHARJ CITY		INDEX		PLANT NO.	DRAWING NUMBER
00	13 06	FOR APPROVAL	OPRG. DEPT. CTPD	ENG. DEPT. AUT-PSAC	RIYADH SAUDI ARABIA		- C421		CD-322935	SHEET NO. L02
REV. NO.	DATE	DESCRIPTION								CONT. L03
										REV. NO. 02

	1	2	3	4	5	6	7	8	9	10
A	SR. NO.	GA. REF.	SCH. REF.	D E S C R I P T I O N		SHEET. NO.	QTY.	TYPE	MAKE	ORDERING INFORMATION
	16	U32.101	74AVC1	DUAL COIL RELAY FOR AVC1 DC SUPERVISION		236	3	RXSF1	ABB	RK 271 019-AN
		U32.107	74AVC2	AUX. VOLTAGE :110-125V DC		336				
		U32.301	74AVC3	CONTACTS : 2NO+1NC PER COIL		436				
B	17	U32.307	IC1X	DUAL COIL RELAY FOR CONTACT MULTIPLICATION(13.8KV)		231	5	RXMB1	ABB	1MRK 000 803-AN
		U32.113	IC2X	AUX. VOLTAGE :110-125V DC						
		U32.313	IC3X	CONTACTS : 3NO PER COIL						
		U32.119	BS1X							
		U32.319	BS2X							
C	18	U32.125	Y1/Y2	DUAL COIL RELAY FOR OLTC TAP LOWER & RAISE		235	3	RXMB1	ABB	1MRK 000 804-AN
		U32.325	Y3/Y4	AUX. VOLTAGE :110-125V DC		335				
		U32.131	Y5/Y6	CONTACTS : 2NO+1NC PER COIL		435				
	19	U32.331	K1/K2	DUAL COIL RELAY FOR OLTC TAP LOWER & RAISE		233	3	RXMB1	ABB	1MRK 000 803-AN
		U32.137	K3/K4	AUX. VOLTAGE :110-125V DC		333				
		U32.337	K5/K6	CONTACTS : 3NO PER COIL		433				
D	20	U39.5001	Q1	MCB 2 POLE 6A, FOR DC SUPPLY		216	3	S282-K10	ABB	GH S282 0164 R0317
		U39.5002	Q2	WITH 2NC AUXILIARY CONTACT				S2C-H11L		GH S270 1917 R0001
		U39.5003	Q3	Q1 AVC± SUPPLY						
E	21	U39.5004	C01	CONVENIENCE OUTLET 10A, 127V AC		211	1	USM45 &	LEGRAND	74140 & 74180
			C02	CONVENIENCE OUTLET 10A, 220V AC				USMS45		
	22	U39.5005	TJ	TELEPHONE JACK IGANG 4WIRE		211	1	EDF410	EDISON	EDF410
	23		C1,C2	MINIATURE CIRCUIT BREAKER, 2 POLE, 10A FOR		211	1	S202-K10	ABB	2CDS 252 001 R0427
				CONVENIENCE OUTLET WITH AUXILIARY SWITCH, 1NO + 1NC CONTACTS				S2C-H11L		GH 3270 1917 R0001
F			C3	THERMOSTAT FOR SPACE HEATER, 5-60°C		211	1	SK 3110	RITTAL	SK 3110
			C7	ON/OFF SWITCH FOR SPACE HEATER		211	1	M2SS1-10B	ABB	1SFA 611 200 R1006
								MCBH -10		

AS-BUILT BY		DATE	CONTRACT NO.	11131113/00	JOB ORDER NO.	S-13020	LIST OF APPARATUS		الشركة الوطنية لنقل الكهرباء		نقل الكهرباء	
02	13 49	FACTORY ASBUILT	DRAWN BY	RIZ	CHECKED BY	JKR	132/13.8KV (GT1,GT2,GT3) AVC PANEL		National Grid sa			
01	13 25	AS PER SEC COMMENT	DATE STARTED	04.02.2013	DATE COMPLETED		S/S 8709 - 132/13.8KV IN AL-KHARJ CITY					
00	13 06	FOR APPROVAL	PRG. DEPT.	CTPD	ENG. DEPT.	AUT-PSAC	RIYADH SAUDI ARABIA					
REV. NO.	DATE	DESCRIPTION					INDEX	PLANT NO.	DRAWING NUMBER	SHEET NO.	REV. NO.	
							-	C421	CD-322935	L03	L04	02

		1	2	3	4	5	6	7	8	9	10		
A		LABEL REF.	LABEL ENGRAVING	MATERIALS	ENGRAVING	LABEL SIZE	LETTER SIZE	LABEL REF.	LABEL ENGRAVING	MATERIALS	ENGRAVING	LABEL SIZE	LETTER SIZE
		U08.5001	U08.5001 90-1	TRAFOLITE	BLACK LETTERS ON WHITE BACKGROUND	50X15mm	4mm	U28.5001	U28.5001 L13	TRAFOLITE	BLACK LETTERS ON WHITE BACKGROUND	50X15mm	4mm
		U11.5001	U11.5001 90-2	TRAFOLITE	BLACK LETTERS ON WHITE BACKGROUND	50X10mm	3mm	U28.5002	U28.5002 L14	TRAFOLITE	BLACK LETTERS ON WHITE BACKGROUND	50X15mm	4mm
		U14.5001	U14.5001 90-3	TRAFOLITE	BLACK LETTERS ON WHITE BACKGROUND	50X10mm	3mm	U28.5003	U28.5003 L15	TRAFOLITE	BLACK LETTERS ON WHITE BACKGROUND	50X15mm	4mm
		U24.5001	U24.5001 L01	TRAFOLITE	BLACK LETTERS ON WHITE BACKGROUND	50X15mm	4mm	U28.5004	U28.5004 L16	TRAFOLITE	BLACK LETTERS ON WHITE BACKGROUND	50X15mm	4mm
		U24.5002	U24.5002 L02	TRAFOLITE	BLACK LETTERS ON WHITE BACKGROUND	50X15mm	4mm	U28.5005	U28.5005 L17	TRAFOLITE	BLACK LETTERS ON WHITE BACKGROUND	50X15mm	4mm
		U24.5003	U24.5003 L03	TRAFOLITE	BLACK LETTERS ON WHITE BACKGROUND	50X15mm	4mm	U28.5006	U28.5006 L18	TRAFOLITE	BLACK LETTERS ON WHITE BACKGROUND	50X15mm	4mm
		U24.5004	U24.5004 L04	TRAFOLITE	BLACK LETTERS ON WHITE BACKGROUND	50X15mm	4mm	U28.5007	U28.5007 PB5	TRAFOLITE	BLACK LETTERS ON WHITE BACKGROUND	50X15mm	4mm
		U24.5005	U24.5005 L05	TRAFOLITE	BLACK LETTERS ON WHITE BACKGROUND	50X15mm	4mm	U28.5008	U28.5008 PB6	TRAFOLITE	BLACK LETTERS ON WHITE BACKGROUND	50X15mm	4mm
		U24.5006	U24.5006 L06	TRAFOLITE	BLACK LETTERS ON WHITE BACKGROUND	50X15mm	4mm	U30.5005	U30.5005 PBES-3	TRAFOLITE	BLACK LETTERS ON WHITE BACKGROUND	50X15mm	4mm
B		U24.5007	U24.5007 PB1	TRAFOLITE	BLACK LETTERS ON WHITE BACKGROUND	50X15mm	4mm	U30.5006	U30.5006 L1-3	TRAFOLITE	BLACK LETTERS ON WHITE BACKGROUND	50X15mm	4mm
		U24.5008	U24.5008 PB2	TRAFOLITE	BLACK LETTERS ON WHITE BACKGROUND	50X15mm	4mm						
		U30.5001	U30.5001 PBES-1	TRAFOLITE	BLACK LETTERS ON WHITE BACKGROUND	50X15mm	4mm						
		U30.5002	U30.5002 L1-1	TRAFOLITE	BLACK LETTERS ON WHITE BACKGROUND	50X15mm	4mm						
		U26.5001	U26.5001 L07	TRAFOLITE	BLACK LETTERS ON WHITE BACKGROUND	50X15mm	4mm	U17.5001	U20.101 IS-1	ALUMINUM PAPER FOL	BLACK LETTERS	50X10mm	3mm
		U26.5002	U26.5002 L08	TRAFOLITE	BLACK LETTERS ON WHITE BACKGROUND	50X15mm	4mm	U17.5002	U20.107 IS-2	ALUMINUM PAPER FOL	BLACK LETTERS	50X10mm	3mm
		U26.5003	U26.5003 L09	TRAFOLITE	BLACK LETTERS ON WHITE BACKGROUND	50X15mm	4mm	U17.5003	U20.113 IS-3	ALUMINUM PAPER FOL	BLACK LETTERS	50X10mm	3mm
		U26.5004	U26.5004 L10	TRAFOLITE	BLACK LETTERS ON WHITE BACKGROUND	50X15mm	4mm	U17.5004	U20.119 IS-DV1	ALUMINUM PAPER FOL	BLACK LETTERS	50X10mm	3mm
		U26.5005	U26.5005 L11	TRAFOLITE	BLACK LETTERS ON WHITE BACKGROUND	50X15mm	4mm	U17.5005	U20.125 IS-DV2	ALUMINUM PAPER FOL	BLACK LETTERS	50X10mm	3mm
		U26.5006	U26.5006 L12	TRAFOLITE	BLACK LETTERS ON WHITE BACKGROUND	50X15mm	4mm	U17.5006	U20.131 IS-DV3	ALUMINUM PAPER FOL	BLACK LETTERS	50X10mm	3mm
C		U26.5007	U26.5007 PB3	TRAFOLITE	BLACK LETTERS ON WHITE BACKGROUND	50X15mm	4mm	U32.101	U32.101 74 AVC1	ALUMINUM PAPER FOL	BLACK LETTERS	50X10mm	3mm
		U26.5008	U26.5008 PB4	TRAFOLITE	BLACK LETTERS ON WHITE BACKGROUND	50X15mm	4mm	U32.107	U32.107 74 AVC2	ALUMINUM PAPER FOL	BLACK LETTERS	50X10mm	3mm
		U30.5003	U30.5003 PBES-2	TRAFOLITE	BLACK LETTERS ON WHITE BACKGROUND	50X15mm	4mm	U32.301	U32.301 74 AVC3	ALUMINUM PAPER FOL	BLACK LETTERS	50X10mm	3mm
		U30.5004	U30.5004 L1-2	TRAFOLITE	BLACK LETTERS ON WHITE BACKGROUND	50X15mm	4mm	U32.307	U32.307 IC1X	ALUMINUM PAPER FOL	BLACK LETTERS	50X10mm	3mm
		U32.125	U32.125 Y172	ALUMINUM PAPER FOL	BLACK LETTERS	50X10mm	3mm	U32.113	U32.113 IC2X	ALUMINUM PAPER FOL	BLACK LETTERS	50X10mm	3mm
		U32.325	U32.325 Y374	ALUMINUM PAPER FOL	BLACK LETTERS	50X10mm	3mm	U32.313	U32.313 IC3X	ALUMINUM PAPER FOL	BLACK LETTERS	50X10mm	3mm
		U32.131	U32.131 Y576	ALUMINUM PAPER FOL	BLACK LETTERS	50X10mm	3mm	U32.119	U32.119 BS1X	ALUMINUM PAPER FOL	BLACK LETTERS	50X10mm	3mm
								U32.319	U32.319 BS2X	ALUMINUM PAPER FOL	BLACK LETTERS	50X10mm	3mm
D													
E													
F													

AS-BUILT BY _____ DATE _____ CONTRACT NO. **1113113/00** JOB ORDER NO. **S-13020**

02	13 49	FACTORY ASBUILT	DRAWN BY RIZ CHECKED BY JKR
01	13 25	AS PER SEC COMMENT	DATE STARTED 04.02.2013 DATE COMPLETED _____
00	13 06	FOR APPROVAL	PRG. DEPT. CTPD ENG. DEPT. AUT-PSAC
REV. NO.	DATE	DESCRIPTION	

LIST OF APPARATUS

132/13.8KV (GT1,GT2,GT3) AVC PANEL

S/S 8709 - 132/13.8KV IN AL-KHARJ CITY

RIYADH SAUDI ARABIA

نقل الكهرباء **الشركة الوطنية لنقل الكهرباء**

National Grid SA

INDEX	PLANT NO.	DRAWING NUMBER	SHEET NO.	REV. NO.
-	C421	CD-322935	L05 L06	02

	1	2	3	4	5	6	7	8	9	10
A										
B										
C										
D										
E										
F										
G										

LABEL REF.	LABEL ENGRAVING	MATERIALS	ENGRAVING	LABEL SIZE	LETTER SIZE
U39.5001	U39.5001 01	TRAFOLITE	BLACK LETTERS ON WHITE BACKGROUND	50X15mm	4mm
U39.5002	U39.5002 02	TRAFOLITE	BLACK LETTERS ON WHITE BACKGROUND	50X10mm	3mm
U39.5003	U39.5003 03	TRAFOLITE	BLACK LETTERS ON WHITE BACKGROUND	50X10mm	3mm
U39.5004	U39.5004 C01,C02	TRAFOLITE	BLACK LETTERS ON WHITE BACKGROUND	50X15mm	4mm
U39.5005	U39.5005 J	TRAFOLITE	BLACK LETTERS ON WHITE BACKGROUND	50X15mm	4mm
U32.331	U32.331 R1/R2	ALUMINUM PAPER FOIL	BLACK LETTERS	50X10mm	3mm
U32.137	U32.137 R3/R4	ALUMINUM PAPER FOIL	BLACK LETTERS	50X10mm	3mm
U32.337	U32.337 R5/R6	ALUMINUM PAPER FOIL	BLACK LETTERS	50X10mm	3mm

AS-BUILT BY _____ DATE _____		CONTRACT NO. 11131113/00	JOB ORDER NO. S-13020	LIST OF APPARATUS		نقل الكهرباء الشركة الوطنية لنقل الكهرباء National Grid sa	
02	13 49	FACTORY ASBUILT		DRAWN BY RIZ CHECKED BY JKR		132/13.8KV (GT1,GT2,GT3) AVC PANEL S/S 8709 - 132/13.8KV IN AL-KHARJ CITY RIYADH SAUDI ARABIA	
01	13 25	AS PER SEC COMMENT		DATE STARTED 04.02.2013 DATE COMPLETED _____		INDEX PLANT NO. DRAWING NUMBER SHEET NO. REV. NO. - C421 CD-322935 L06 L07 02	
00	13 06	FOR APPROVAL		OPRG. DEPT. CTPD ENG. DEPT. AUT-PSAC			
REV. NO.	DATE	DESCRIPTION					

THIS DRAWING AND THE INFORMATION CONTAINED HEREIN ARE THE SOLE PROPERTY OF NATIONAL GRID SA. NO REPRODUCTION OR TRANSMISSION IN ANY FORM OR BY ANY MEANS, ELECTRONIC OR MECHANICAL, INCLUDING PHOTOCOPYING, RECORDING, OR BY ANY INFORMATION STORAGE AND RETRIEVAL SYSTEM, IS PERMITTED WITHOUT THE WRITTEN CONSENT OF ITS OWNER.

LABEL REF.	LABEL ENGRAVING	MATERIALS	ENGRAVING	LABEL SIZE	LETTER SIZE
C1	C1 127V AC SUPPLY MCB	TRAFOLITE	BLACK LETTERS ON WHITE BACKGROUND	50X15mm	4mm
C2	C2 220V AC SUPPLY MCB	TRAFOLITE	BLACK LETTERS ON WHITE BACKGROUND	50X15mm	4mm
C3	C3 THERMOSTAT	TRAFOLITE	BLACK LETTERS ON WHITE BACKGROUND	50X15mm	4mm
C7	C7 ON/OFF SWITCH	TRAFOLITE	BLACK LETTERS ON WHITE BACKGROUND	50X15mm	4mm
DS	DS DOOR SWITCH	TRAFOLITE	BLACK LETTERS ON WHITE BACKGROUND	50X15mm	4mm
IL	IL ILLUMINATION LAMP	TRAFOLITE	BLACK LETTERS ON WHITE BACKGROUND	50X15mm	4mm
SH	SH SPACE HEATER	TRAFOLITE	BLACK LETTERS ON WHITE BACKGROUND	50X15mm	4mm

AS-BUILT BY _____ DATE _____		CONTRACT NO. 1113113/00	JOB ORDER NO. S-13020	LIST OF APPARATUS		نقل الكهرباء الشركة الوطنية لنقل الكهرباء National Grid sa	
02	13 49	FACTORY ASBUILT		132/13.8KV (GT1,GT2,GT3) AVC PANEL		INDEX	PLANT NO.
01	13 25	AS PER SEC COMMENT		S/S 8709 - 132/13.8KV IN AL-KHARJ CITY		DRAWING NUMBER	
00	13 06	FOR APPROVAL		RIYADH SAUDI ARABIA		SHEET NO.	
REV. NO.	DATE	DESCRIPTION	OPRG. DEPT. CTPD	ENG. DEPT. AUT-PSAC		- C421	CD-322935
						L07	02



POWER SYSTEMS NETWORK MANAGEMENT
PROTECTION AND SUBSTATION AUTOMATION SYSTEMS
WBS NO: S-13020

ABB AUTOMATION COMPANY LTD.
414, AL-KHARJ ROAD
SECOND INDUSTRIAL CITY
RIYADH-11383 K.S.A

CONTRACTOR : ABB Contracting Company
CLIENT : National Gridsa
PROJECT : CONSTRUCTION OF NEW 132/13.8kv SS 8709 IN AL-KHARJ CITY
SUBSTATION : S/S 8709
CONTRACT NO. : 11131113/00
TITLE : SCHEMATIC DRAWING +AVC

AS-BUILT BY		DATE	CONTRACT NO. 11131113/00	JOB ORDER NO. S-13020	COVER SHEET		الشركة الوطنية لنقل الكهرباء		نقل الكهرباء	
02	13 49	FACTORY ASBUILT	DRAWN BY RIZ	CHECKED BY JKR	132/13.8KV (GT1,GT2,GT3) AVC PANEL		National Grid sa			
01	13 25	AS PER SEC COMMENT	DATE STARTED 04.02.2013 DATE COMPLETED		S/S 8709 - 132/13.8KV IN AL-KHARJ CITY		INDEX	PLANT NO.	DRAWING NUMBER	SHEET NO.
00	13 06	FOR APPROVAL	OPRG. DEPT. CTPD ENG. DEPT. AUT-PSAC		RIYADH SAUDI ARABIA		-	C421	CD-322936	001 002
REV. NO.	DATE	DESCRIPTION								REV. NO.

1 2 3 4 5 6 7 8 9 10

A

B

C

D

E

F

CONTENTS	ABB SHT.NO.	REV.00	REV.01	REV.02
COVER SHEET	001	X	X	X
CONTENTS SHEET	002	X	X	X
GRAPHICAL SYMBOLS FOR DIAGRAMS	011	X	X	X
GRAPHICAL SYMBOLS FOR DIAGRAMS	012	X	X	X
COMMON LEGEND	013	X	X	X
FERRULE AND WIRING DETAILS	014	X	X	X
DRAWING REFERENCES	015	X	X	X
AC SUPPLY FOR ILLUMINATION & POWER SOCKET	211	X	X	X
CUB. LIGHTING, HEATER & SOCKET ALARM CKT.	212	X	X	X
DC SUPPLY DISTRIBUTION	216	X	X	X
CT & VT CIRCUITS 90 RELAY FOR GT1,GT2,GT3	221,222,223	X	X	X
BINARY INPUTS-GT1,GT2,GT3	231,331,431	X	X	X
BINARY INPUTS-GT1,GT2,GT3	233,333,433	X	X	X
TAP CHANGER RAISE/LOWER CIRCUITS	235,335,435	X	X	X
INDICATION CIRCUITS	236,336,436	X	X	X
TAP CHANGER RAISE/LOWER CIRCUITS	237,337,437	X	X	X
STN-COMMN ALARM CIRCUITS	293,393,493	X	X	X
BLOCK REFERENCE	498-502	X	X	X
TERMINAL BLOCK ALLOCATION	503-504	X	X	X

G

AS-BUILT BY _____ DATE _____		CONTRACT NO. 11131113/00		JOB ORDER NO. S-13020		CONTENTS SHEET 132/13.8KV (GT1,GT2,GT3) AVC PANEL S/S 8709 - 132/13.8KV IN AL-KHARJ CITY RIYADH SAUDI ARABIA		الشركة الوطنية لنقل الكهرباء National Grid sa			
02 13 49 01 13 25 00 13 06		FACTORY ASBUILT AS PER SEC COMMENT FOR APPROVAL		DRAWN BY RIZ CHECKED BY JKR DATE STARTED 04.02.2013 DATE COMPLETED _____ PRG. DEPT. CTPD ENG. DEPT. AUT-PSAC						INDEX -	PLANT NO. C421

THIS DRAWING AND THE INFORMATION CONTAINED HEREIN ARE THE SOLE PROPERTY OF NATIONAL GRID SAUDI ARABIA. NO REPRODUCTION OR TRANSMISSION IN ANY FORM OR BY ANY MEANS, WITHOUT THE WRITTEN CONSENT OF NATIONAL GRID SAUDI ARABIA, IS PERMITTED.

1	2	3	4	5	6	7	8	9	10																																																																																																																		
A																																																																																																																											
B																																																																																																																											
C																																																																																																																											
D																																																																																																																											
E																																																																																																																											
F																																																																																																																											
<table><tr><th>SYMBOL</th><th>DESCRIPTION</th><th>SYMBOL</th><th>DESCRIPTION</th><th>SYMBOL</th><th>DESCRIPTION</th></tr><tr><td></td><td>FRAME CONNECTION</td><td></td><td>MAIN CONTACT OF A CIRCUIT BREAKER</td><td></td><td>RELAY WITH TWO MAKE CONTACTS, ONE OF THEM DELAYED WHEN OPERATING</td></tr><tr><td></td><td>EARTH CONNECTION</td><td></td><td>PASSING MAKE CONTACT CLOSING MOMENTARILY DURING OPERATION AND RELEASE</td><td></td><td>RELAY WITH TWO ACTUATORS AND A TWO STABLE POSITIONS</td></tr><tr><td></td><td>RESISTOR</td><td></td><td>BREAK CONTACT DELAYED WHEN OPERATING</td><td></td><td>SIGNALLING LAMP</td></tr><tr><td></td><td>VARIABLE RESISTOR</td><td></td><td>MAKE CONTACT DELAYED WHEN RELEASING</td><td></td><td>MECHANICAL INDICATOR WITH AUTOMATIC RESET</td></tr><tr><td></td><td>RESISTOR WITH PRESET ADJUSTMENT</td><td></td><td>TWO MECHANICAL LINKS CROSSING WITHOUT CONNECTION</td><td></td><td>MECHANICAL INDICATOR WITH NON-AUTOMATIC RESET</td></tr><tr><td></td><td>CAPACITOR</td><td></td><td>JUNCTION OF MECHANICAL LINKS</td><td></td><td>ELECTRICALLY CONTROLLED MECHANICAL INDICATOR WITH AUTOMATIC RESET</td></tr><tr><td></td><td>SEMICONDUCTOR DIODE USED AS A CAPACITIVE DEVICE</td><td></td><td>AUTOMATIC RESET</td><td></td><td>ELECTRICALLY CONTROLLED MECHANICAL INDICATOR WITH NON-AUTOMATIC RESET</td></tr><tr><td></td><td>OPEN CONTACT, MAKE CONTACT</td><td></td><td>NON-AUTOMATIC RESET</td><td></td><td>RELAY WITH MAKE CONTACT</td></tr><tr><td></td><td>CLOSED CONTACT, BREAK CONTACT</td><td></td><td>SWITCHING DEVICE WITH MANUAL OPERATION AND WITH AUTOMATIC RESET</td><td></td><td>RELAY WITH CHANGE-OVER CONTACT</td></tr><tr><td></td><td>CHANGE-OVER CONTACT, BREAK BEFORE MAKE</td><td></td><td>SWITCHING DEVICE WITH MANUAL OPERATION AND WITH NON-AUTOMATIC RESET</td><td></td><td>ELECTRO-MECHANICAL POSITION INDICATOR WITH ONE DE-ENERGIZED AND ONE OPERATED POSITION</td></tr><tr><td></td><td>MAKE CONTACT WHICH IS EARLY WHEN OPERATING AND LATE WHEN RELEASING</td><td></td><td>CHANGE-OVER SWITCHING DEVICE WITH MANUAL CONTROL AUTOMATIC RESET FROM POSITION 1-2 TO THE NEUTRAL POSITION</td><td></td><td>ELECTRO-MECHANICAL POSITION INDICATOR WITH ONE DE-ENERGIZED AND TWO OPERATED POSITION</td></tr><tr><td></td><td>BREAK CONTACT WHICH IS LATE WHEN OPERATING AND EARLY WHEN RELEASING</td><td></td><td>RELAY WITH MAKE CONTACT</td><td></td><td>BELL, BUZZER</td></tr><tr><td></td><td>SWITCHING DEVICE WITH MANUAL CONTROL</td><td></td><td>RELAY WITH MAKE CONTACT, DELAYED WHEN OPERATING</td><td></td><td>SIREN , HORN</td></tr><tr><td></td><td>MAKE CONTACT DELAYED WHEN OPERATING</td><td></td><td>RELAY WITH MAKE CONTACT, DELAYED WHEN RELEASING</td><td></td><td></td></tr><tr><td></td><td>BREAK CONTACT DELAYED WHEN RELEASING</td><td></td><td>RELAY WITH MAKE CONTACT, DELAYED WHEN OPERATING AND RELEASING</td><td></td><td></td></tr><tr><td></td><td>MAKE CONTACT DELAYED WHEN OPERATING AND RELEASING</td><td></td><td></td><td></td><td></td></tr><tr><td></td><td>MAIN CONTACT OF A SWITCH DISCONNECTOR</td><td></td><td></td><td></td><td></td></tr><tr><td></td><td>MAIN CONTACT OF A DISCONNECTOR</td><td></td><td></td><td></td><td></td></tr></table>										SYMBOL	DESCRIPTION	SYMBOL	DESCRIPTION	SYMBOL	DESCRIPTION		FRAME CONNECTION		MAIN CONTACT OF A CIRCUIT BREAKER		RELAY WITH TWO MAKE CONTACTS, ONE OF THEM DELAYED WHEN OPERATING		EARTH CONNECTION		PASSING MAKE CONTACT CLOSING MOMENTARILY DURING OPERATION AND RELEASE		RELAY WITH TWO ACTUATORS AND A TWO STABLE POSITIONS		RESISTOR		BREAK CONTACT DELAYED WHEN OPERATING		SIGNALLING LAMP		VARIABLE RESISTOR		MAKE CONTACT DELAYED WHEN RELEASING		MECHANICAL INDICATOR WITH AUTOMATIC RESET		RESISTOR WITH PRESET ADJUSTMENT		TWO MECHANICAL LINKS CROSSING WITHOUT CONNECTION		MECHANICAL INDICATOR WITH NON-AUTOMATIC RESET		CAPACITOR		JUNCTION OF MECHANICAL LINKS		ELECTRICALLY CONTROLLED MECHANICAL INDICATOR WITH AUTOMATIC RESET		SEMICONDUCTOR DIODE USED AS A CAPACITIVE DEVICE		AUTOMATIC RESET		ELECTRICALLY CONTROLLED MECHANICAL INDICATOR WITH NON-AUTOMATIC RESET		OPEN CONTACT, MAKE CONTACT		NON-AUTOMATIC RESET		RELAY WITH MAKE CONTACT		CLOSED CONTACT, BREAK CONTACT		SWITCHING DEVICE WITH MANUAL OPERATION AND WITH AUTOMATIC RESET		RELAY WITH CHANGE-OVER CONTACT		CHANGE-OVER CONTACT, BREAK BEFORE MAKE		SWITCHING DEVICE WITH MANUAL OPERATION AND WITH NON-AUTOMATIC RESET		ELECTRO-MECHANICAL POSITION INDICATOR WITH ONE DE-ENERGIZED AND ONE OPERATED POSITION		MAKE CONTACT WHICH IS EARLY WHEN OPERATING AND LATE WHEN RELEASING		CHANGE-OVER SWITCHING DEVICE WITH MANUAL CONTROL AUTOMATIC RESET FROM POSITION 1-2 TO THE NEUTRAL POSITION		ELECTRO-MECHANICAL POSITION INDICATOR WITH ONE DE-ENERGIZED AND TWO OPERATED POSITION		BREAK CONTACT WHICH IS LATE WHEN OPERATING AND EARLY WHEN RELEASING		RELAY WITH MAKE CONTACT		BELL, BUZZER		SWITCHING DEVICE WITH MANUAL CONTROL		RELAY WITH MAKE CONTACT, DELAYED WHEN OPERATING		SIREN , HORN		MAKE CONTACT DELAYED WHEN OPERATING		RELAY WITH MAKE CONTACT, DELAYED WHEN RELEASING				BREAK CONTACT DELAYED WHEN RELEASING		RELAY WITH MAKE CONTACT, DELAYED WHEN OPERATING AND RELEASING				MAKE CONTACT DELAYED WHEN OPERATING AND RELEASING						MAIN CONTACT OF A SWITCH DISCONNECTOR						MAIN CONTACT OF A DISCONNECTOR				
SYMBOL	DESCRIPTION	SYMBOL	DESCRIPTION	SYMBOL	DESCRIPTION																																																																																																																						
	FRAME CONNECTION		MAIN CONTACT OF A CIRCUIT BREAKER		RELAY WITH TWO MAKE CONTACTS, ONE OF THEM DELAYED WHEN OPERATING																																																																																																																						
	EARTH CONNECTION		PASSING MAKE CONTACT CLOSING MOMENTARILY DURING OPERATION AND RELEASE		RELAY WITH TWO ACTUATORS AND A TWO STABLE POSITIONS																																																																																																																						
	RESISTOR		BREAK CONTACT DELAYED WHEN OPERATING		SIGNALLING LAMP																																																																																																																						
	VARIABLE RESISTOR		MAKE CONTACT DELAYED WHEN RELEASING		MECHANICAL INDICATOR WITH AUTOMATIC RESET																																																																																																																						
	RESISTOR WITH PRESET ADJUSTMENT		TWO MECHANICAL LINKS CROSSING WITHOUT CONNECTION		MECHANICAL INDICATOR WITH NON-AUTOMATIC RESET																																																																																																																						
	CAPACITOR		JUNCTION OF MECHANICAL LINKS		ELECTRICALLY CONTROLLED MECHANICAL INDICATOR WITH AUTOMATIC RESET																																																																																																																						
	SEMICONDUCTOR DIODE USED AS A CAPACITIVE DEVICE		AUTOMATIC RESET		ELECTRICALLY CONTROLLED MECHANICAL INDICATOR WITH NON-AUTOMATIC RESET																																																																																																																						
	OPEN CONTACT, MAKE CONTACT		NON-AUTOMATIC RESET		RELAY WITH MAKE CONTACT																																																																																																																						
	CLOSED CONTACT, BREAK CONTACT		SWITCHING DEVICE WITH MANUAL OPERATION AND WITH AUTOMATIC RESET		RELAY WITH CHANGE-OVER CONTACT																																																																																																																						
	CHANGE-OVER CONTACT, BREAK BEFORE MAKE		SWITCHING DEVICE WITH MANUAL OPERATION AND WITH NON-AUTOMATIC RESET		ELECTRO-MECHANICAL POSITION INDICATOR WITH ONE DE-ENERGIZED AND ONE OPERATED POSITION																																																																																																																						
	MAKE CONTACT WHICH IS EARLY WHEN OPERATING AND LATE WHEN RELEASING		CHANGE-OVER SWITCHING DEVICE WITH MANUAL CONTROL AUTOMATIC RESET FROM POSITION 1-2 TO THE NEUTRAL POSITION		ELECTRO-MECHANICAL POSITION INDICATOR WITH ONE DE-ENERGIZED AND TWO OPERATED POSITION																																																																																																																						
	BREAK CONTACT WHICH IS LATE WHEN OPERATING AND EARLY WHEN RELEASING		RELAY WITH MAKE CONTACT		BELL, BUZZER																																																																																																																						
	SWITCHING DEVICE WITH MANUAL CONTROL		RELAY WITH MAKE CONTACT, DELAYED WHEN OPERATING		SIREN , HORN																																																																																																																						
	MAKE CONTACT DELAYED WHEN OPERATING		RELAY WITH MAKE CONTACT, DELAYED WHEN RELEASING																																																																																																																								
	BREAK CONTACT DELAYED WHEN RELEASING		RELAY WITH MAKE CONTACT, DELAYED WHEN OPERATING AND RELEASING																																																																																																																								
	MAKE CONTACT DELAYED WHEN OPERATING AND RELEASING																																																																																																																										
	MAIN CONTACT OF A SWITCH DISCONNECTOR																																																																																																																										
	MAIN CONTACT OF A DISCONNECTOR																																																																																																																										

AS-BUILT BY		DATE	CONTRACT NO.	1113113/00	JOB ORDER NO.	S-13020	GRAPHICAL SYMBOLS FOR DIAGRAMS		الشركة الوطنية لنقل الكهرباء		نقل الكهرباء		
02	13	49	FACTORY ASBUILT		DRAWN BY		RIZ	CHECKED BY	JKR	132/13.8KV (GT1,GT2,GT3) AVC PANEL		National Grid sa	
01	13	25	AS PER SEC COMMENT		DATE STARTED		04.02.2013	DATE COMPLETED		S/S 8709 - 132/13.8KV IN AL-KHARJ CITY		INDEX	
00	13	06	FOR APPROVAL		PRG. DEPT.		CTPD	ENG. DEPT.		AUT-PSAC	RIYADH		SAUDI ARABIA
REV. NO.	DATE	DESCRIPTION		DRAWING NUMBER		SHEET NO.		CONT.		REV. NO.			
				C421		CD-322936		011		012		02	

	1	2	3	4	5	6	7	8	9	10
A										
B										
C										
D										
E										
F										

SYMBOL	DESCRIPTION	SYMBOL	DESCRIPTION	SYMBOL	DESCRIPTION
	FUSE / LINK		WATTMETER		ELEMENT WITH NEGATED INHIBITING INPUT
	FUSE WITH THE SUPPLY SIDE INDICATED		VARMETER		ELEMENT WITH INPUT WHICH DOES NOT CARRY ANY LOGIC INFORMATION
	SINGLE-PHASE TRANSFORMER WITH TWO SEPARATE WINDINGS (TWO ALTERNATIVE FORMS)		POWER FACTOR METER		ELEMENT WITH POSTPONED OUTPUT
	SINGLE-PHASE TRANSFORMER WITH THREE SEPARATE WINDINGS (TWO ALTERNATIVE FORMS)		POSITION INDICATOR		AND-ELEMENT WITH TWO INPUTS
	SINGLE-PHASE TRANSFORMER WITH FERRO MAGNETIC CORE		SYNCHROSCOPE		OR-ELEMENT WITH TWO INPUTS
	SINGLE-PHASE VOLTAGE TRANSFORMER (MULTI-LINE AND SINGLE-LINE REPRESENTATION)		RECORDING VOLTMETER		LOGIC THRESHOLD ELEMENT WITH FOUR INPUTS AND THRESHOLD VALUE 2
	SINGLE-PHASE VOLTAGE TRANSFORMER WITH TWO SECONDARY WINDINGS (MULTI-LINE AND SINGLE-LINE REPRESENTATION)		RECORDING WATTMETER		ELEMENT WITH THREE INPUTS FOR "2 AND ONLY 2"
	CURRENT TRANSFORMER (MULTI-LINE AND SINGLE-LINE REPRESENTATION)		HOUR METER		EXCLUSIVE OR-ELEMENT WITH THREE INPUTS
	CURRENT TRANSFORMER WITH TWO CORES (MULTI-LINE AND SINGLE-LINE REPRESENTATION)		WATT-HOUR METER		LOGIC IDENTITY ELEMENT WITH THREE INPUTS
	CURRENT TRANSFORMER WITH TWO SECONDARY WINDINGS ON ONE CORE (MULTI-LINE AND SINGLE-LINE REPRESENTATION)		WATT-HOUR METER FOR ENERGY FROM A BUSBAR SYSTEM		MAJORITY ELEMENT WITH THREE INPUTS
	FILTER		ELEMENT WITH STATIC INPUT		NEGATOR
	HIGH-PASS FILTER		ELEMENT WITH STATIC NEGATED INPUT		NAND ELEMENT WITH TWO INPUTS
	BAND-PASS FILTER		ELEMENT WITH STATIC NEGATED OUTPUT		NOR ELEMENT WITH TWO INPUTS
	VOLTMETER		ELEMENT WITH DYNAMIC INPUT		BISTABLE ELEMENT
	AMMETER		ELEMENT WITH DYNAMIC NEGATED INPUT		
			ELEMENT WITH INHIBITING INPUT		

AS-BUILT BY _____ DATE _____ CONTRACT NO. 11131113/00 JOB ORDER NO. S-13020

02	13 49	FACTORY ASBUILT
01	13 25	AS PER SEC COMMENT
00	13 06	FOR APPROVAL
REV. NO.	DATE	DESCRIPTION

DRAWN BY	RIZ	CHECKED BY	JKR
DATE STARTED	04.02.2013	DATE COMPLETED	
OPRG. DEPT.	CTPD	ENG. DEPT.	AUT-PSAC

GRAPHICAL SYMBOLS FOR DIAGRAMS

132/13.8KV (GT1,GT2,GT3) AVC PANEL
S/S 8709 - 132/13.8KV IN AL-KHARJ CITY
RIYADH SAUDI ARABIA

الشركة الوطنية لنقل الكهرباء



INDEX	PLANT NO.	DRAWING NUMBER	SHEET NO.	REV. NO.
-	C421	CD-322936	012 013	02

LEGENDS

±R1	DC SUPPLY - MAIN PROTECTION
±R2	DC SUPPLY - SECONDARY PROTECTION
±R3	DC SUPPLY - BACK UP PROTECTION
±IT	DC SUPPLY - INTER TRIP
FL	DC SUPPLY - FLASHING CIRCUIT
BB RS±	DC SUPPLY - BUS BAR - PROTECTION RESET
BB CBF±/CBF±	DC SUPPLY - CBF PROTECTION
R	RESET BUS - ALARM SYSTEM
CR	CONTROL ROOM
ECC	ENERGY CONTROL CENTRE
LOCAL	THE LOCATION OF CONTROLLED DEVICE
REMOTE	ANY OTHER LOCATION NOT LOCAL
ON	CB NORMALLY OPEN AUXILIARY CONTACT
OFF	CB NORMALLY CLOSED AUXILIARY CONTACT
A	COMMON
T	TEST POSITION
S	SERVICE POSITION
CS	CLOSE IN SERVICE POSITION
CT	CLOSE IN TEST POSITION
LS	LOCAL SERVICE
LT	LOCAL TEST
LC	LOCAL CLOSE
LO	LOCAL OPEN
RO	REMOTE OPEN

NOTES

LABELS

WHITE LABEL WITH BLACK LETTERING WILL BE PROVIDED FOR ALL MOUNTED APPARATUS EQUIPMENT IDENTIFICATION AND FUNCTION REFERENCE LABEL WILL BE PROVIDED FOR FRONT MOUNTED EQUIPMENTS OF THE PANEL AND EQUIPMENT IDENTIFICATION LABEL WILL BE PROVIDED FOR INTERNALLY MOUNTED EQUIPMENTS

WIRING

PVC INSULATED 600V GRADE
 2.5 SQ.mm. YELLOW COLOURED FOR CT CIRCUITS
 2.5 SQ.mm. RE COLOURED FOR VT CIRCUITS
 1.5 SQ.mm. GREY COLOURED FOR DC SUPPLY, SCADA AND CONTROL CIRCUITS
 2.5 SQ.mm. BLACK COLOURED FOR AVC AND AC CIRCUITS
 2.5 SQ.mm. YELLOW/GREEN COLOURED FOR EARTHING CONNECTIONS
 FOLLOWING MARKERS SHALL BE PROVIDED ON FOLLOWING WIRES:
 + SIGN FOR DC + WIRE
 - SIGN FOR DC - WIRE

LUGS


A. CT CIRCUITS- RING TYPE
 B. OTHER CIRCUITS - SPADE TYPE

FERULLING

YELLOW TUBE 3.2 mm FOR 1.5SQ mm WIRES AND 4.2 FOR 2.5 SQ mm WIRES
 (AS PER 31 - TMSS-1, RE.O)


AS-BUILT BY _____ DATE _____		CONTRACT NO. 1113113/00	JOB ORDER NO. S-13020	COMMON LEGEND		الشركة الوطنية لنقل الكهرباء		نقل الكهرباء	
02	13 49	FACTORY ASBUILT		DRAWN BY RIZ	CHECKED BY JKR	132/13.8KV (GT1,GT2,GT3) AVC PANEL		National Grid sa	
01	13 25	AS PER SEC COMMENT		DATE STARTED 04.02.2013 DATE COMPLETED _____		S/S 8709 - 132/13.8KV IN AL-KHARJ CITY		INDEX PLANT NO. DRAWING NUMBER SHEET NO. REV. NO.	
00	13 06	FOR APPROVAL		OPRG. DEPT. CTPD ENG. DEPT. AUT-PSAC		RIYADH SAUDI ARABIA		- C421 CD-322936 013 014 02	
REV. NO.	DATE	DESCRIPTION							

FOR 132kV RELAY & CONTROL, PROT.N. PANELS

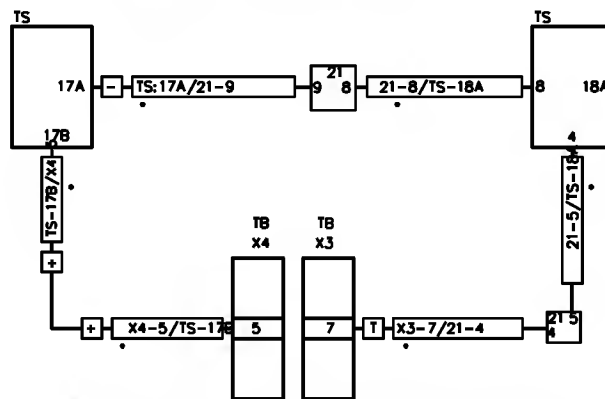

AS PER IEC-391 FIG 14a (W/O SUPPLEMENTARY/IDENTIFICATION MARK)

FOR 132kV PANELS INTERPANEL WIRING

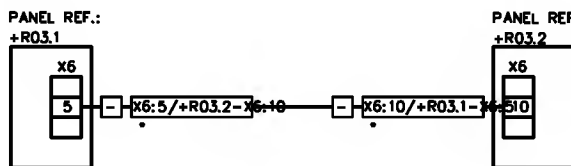

AS PER IEC-391 FIG 14d (W/O SUPPLEMENTARY/IDENTIFICATION MARK)

WIRES -
PVC insulated, stranded,
coiled annealed copper
conductor graded for 1000V

LUGS -
Pre-insulated

- a. CT Circuits - 2.5 Sqmm PVC Yellow colour
- b. VT Circuits - 1.5 Sqmm PVC Red colour
- c. DC, & CONTROL Circuits - 1.5 Sqmm PVC Grey colour
- d. Alarm Circuits - 1.0 Sqmm PVC Blue colour
- e. AVC & AC Circuits - 2.5 Sqmm PVC Black colour
- f. Earth Circuits - 2.5 Sqmm PVC Yellow/Green colour
- a) CT Circuits - Ring type
- b) Other Circuits - Spode type

- NOTE:1 ADDITIONAL MARKING AS APPLICABLE
- NOTE:2 FERRULE NUMBERING WILL BE BLACK LETTERS ON YELLOW TUBE
3.2 mm for 1.5 sq mm wires and
4.2 mm for 2.5 sq mm wires
(As per 31-TWSS-1, REV 0)
- NOTE:3 STARTING POINT OF THE FERRULE LEFT TO RIGHT

AS-BUILT BY _____ DATE _____ CONTRACT NO. 11131113/00 JOB ORDER NO. S-13020

02	13 49	FACTORY ASBUILT	DRAWN BY RIZ	CHECKED BY JKR
01	13 25	AS PER SEC COMMENT	DATE STARTED 04.02.2013	DATE COMPLETED
00	13 06	FOR APPROVAL	PRG. DEPT. CTPD	ENG. DEPT. AUT-PSAC
REV. NO.	DATE	DESCRIPTION		

FERRULE AND WIRING DETAILS

132/13.8KV (GT1,GT2,GT3) AVC PANEL
S/S 8709 - 132/13.8KV IN AL-KHARJ CITY
RIYADH SAUDI ARABIA


الشركة الوطنية لنقل الكهرباء




National Grid sa


INDEX	PLANT NO.	DRAWING NUMBER	SHEET NO.	REV. NO.
-	C421	CD-322936	014	02

1	2	3	4	5	6	7	8	9	10
A									
B									
C									
D									
E									
F									
G									

MANUFACTURER		SCHEMATICS DWG.NO	PANEL DESCRIPTION	PANEL REFERENCE
 PROTECTION & SUBSTATION AUTOMATION			SS 8709 13.8KV RELAY PANELS	
	CD-322952		13.8KV Copocitor Bank-1 Protection Panel	+CBP-1
	CD-322954		13.8KV Copocitor Bank-2 Protection Panel	+CBP-2
	CD-322956		13.8KV Copocitor Bank-2 Protection Panel	+CBP-3
	CD-322956		13.8 KV ACCS PANEL	+ACCS
	CD-322962		13.8KV ACSE PANEL	+ACSE
	CD-322968		13.8KV Under Voltage Load Shedding Panel	+UVLS
	CD-322964		13.8KV Under Frequency Load Shedding Panel-1	+UFLS01
	CD-322966		13.8KV Under Frequency Load Shedding Panel-2	+UFLS02

AS-BUILT BY _____ DATE _____		CONTRACT NO. 11131113/00	JOB ORDER NO. S-13020	DRAWING REFERENCES		الشركة الوطنية لنقل الكهرباء National Grid sa				
02	13 49	FACTORY ASBUILT		132/13.8KV (GT1,GT2,GT3) AVC PANEL						
01	13 25	AS PER SEC COMMENT		S/S 8709 - 132/13.8KV IN AL-KHARJ CITY						
00	13 06	FOR APPROVAL		RIYADH SAUDI ARABIA						
REV. NO.	DATE	DESCRIPTION	OPRG. DEPT. CTPD	ENG. DEPT. AUT-PSAC	INDEX	PLANT NO. C421	DRAWING NUMBER CD-322936	SHEET NO. 016	CONT. 211	REV. NO. 02

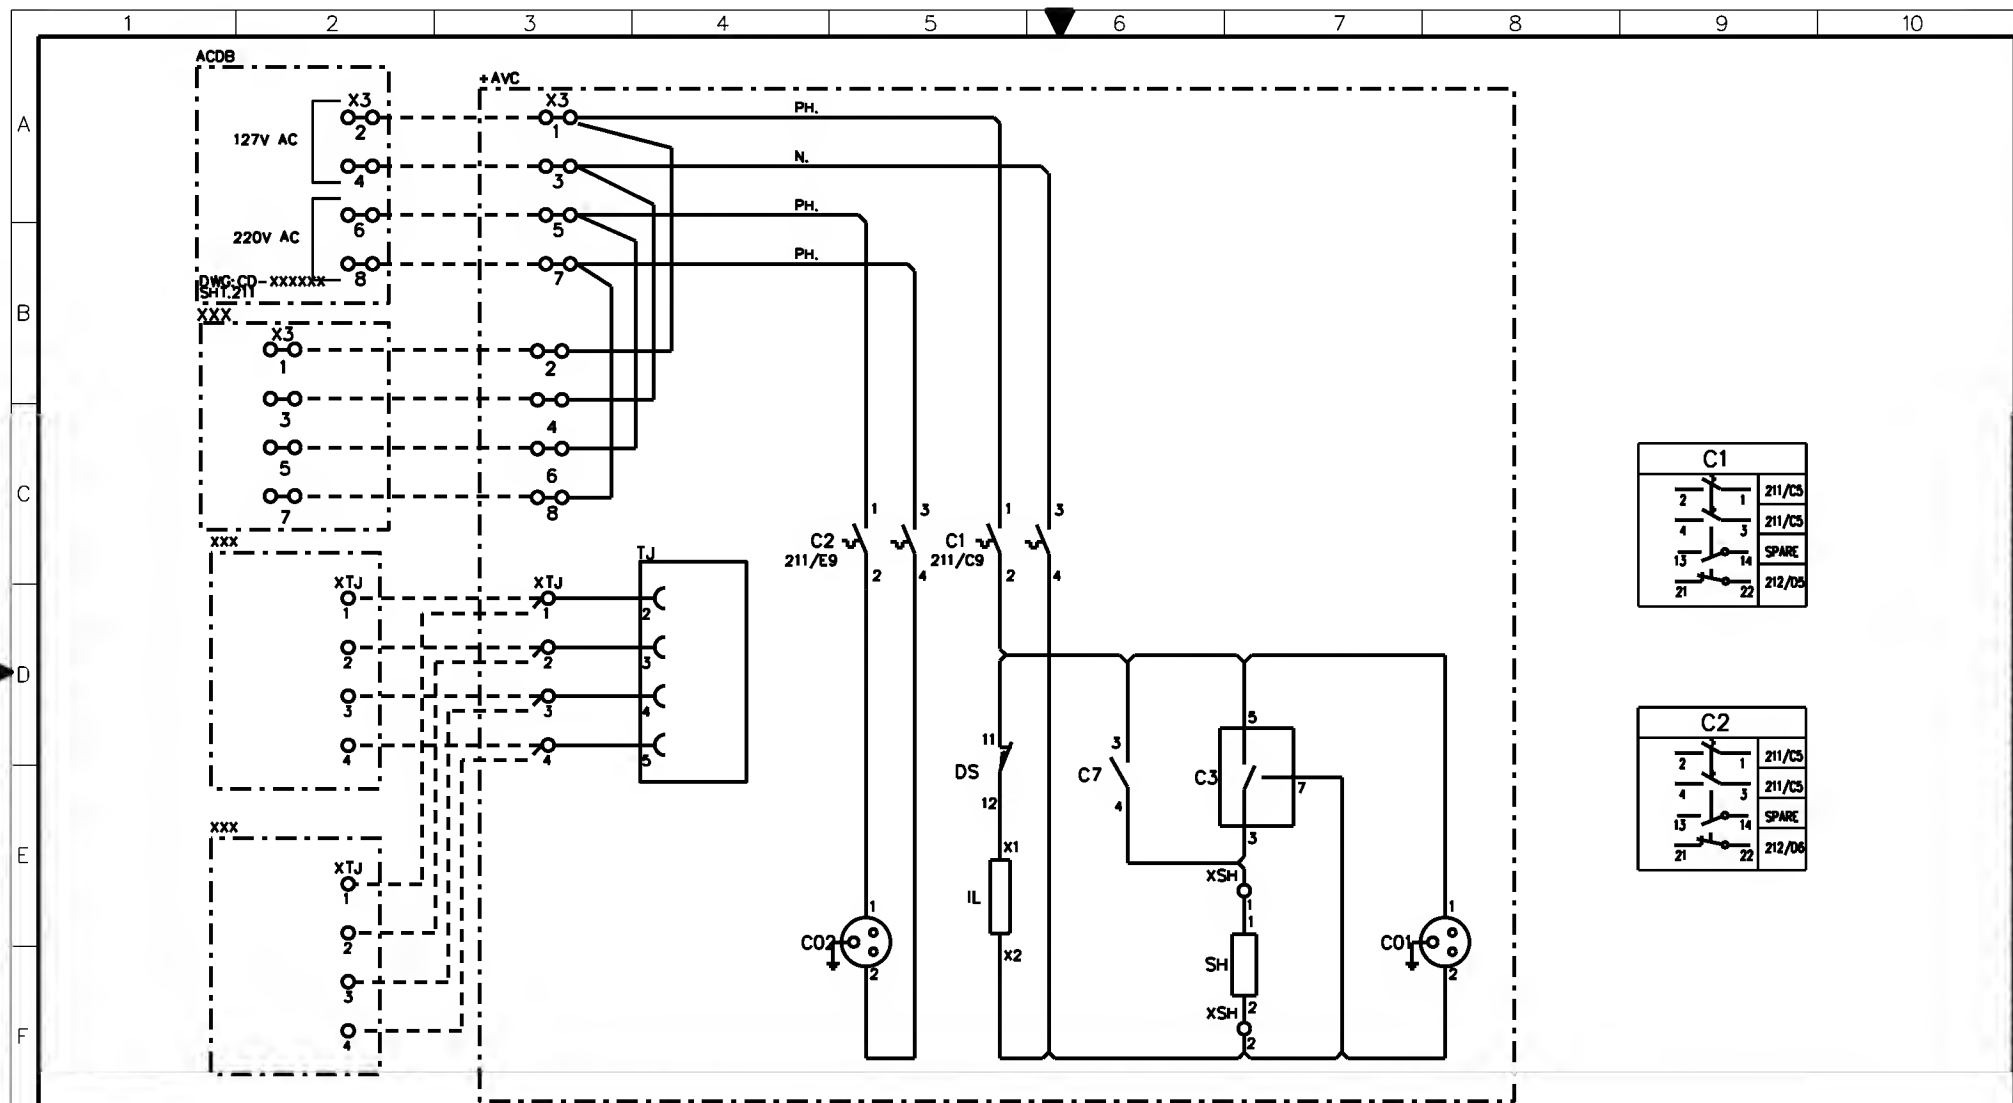

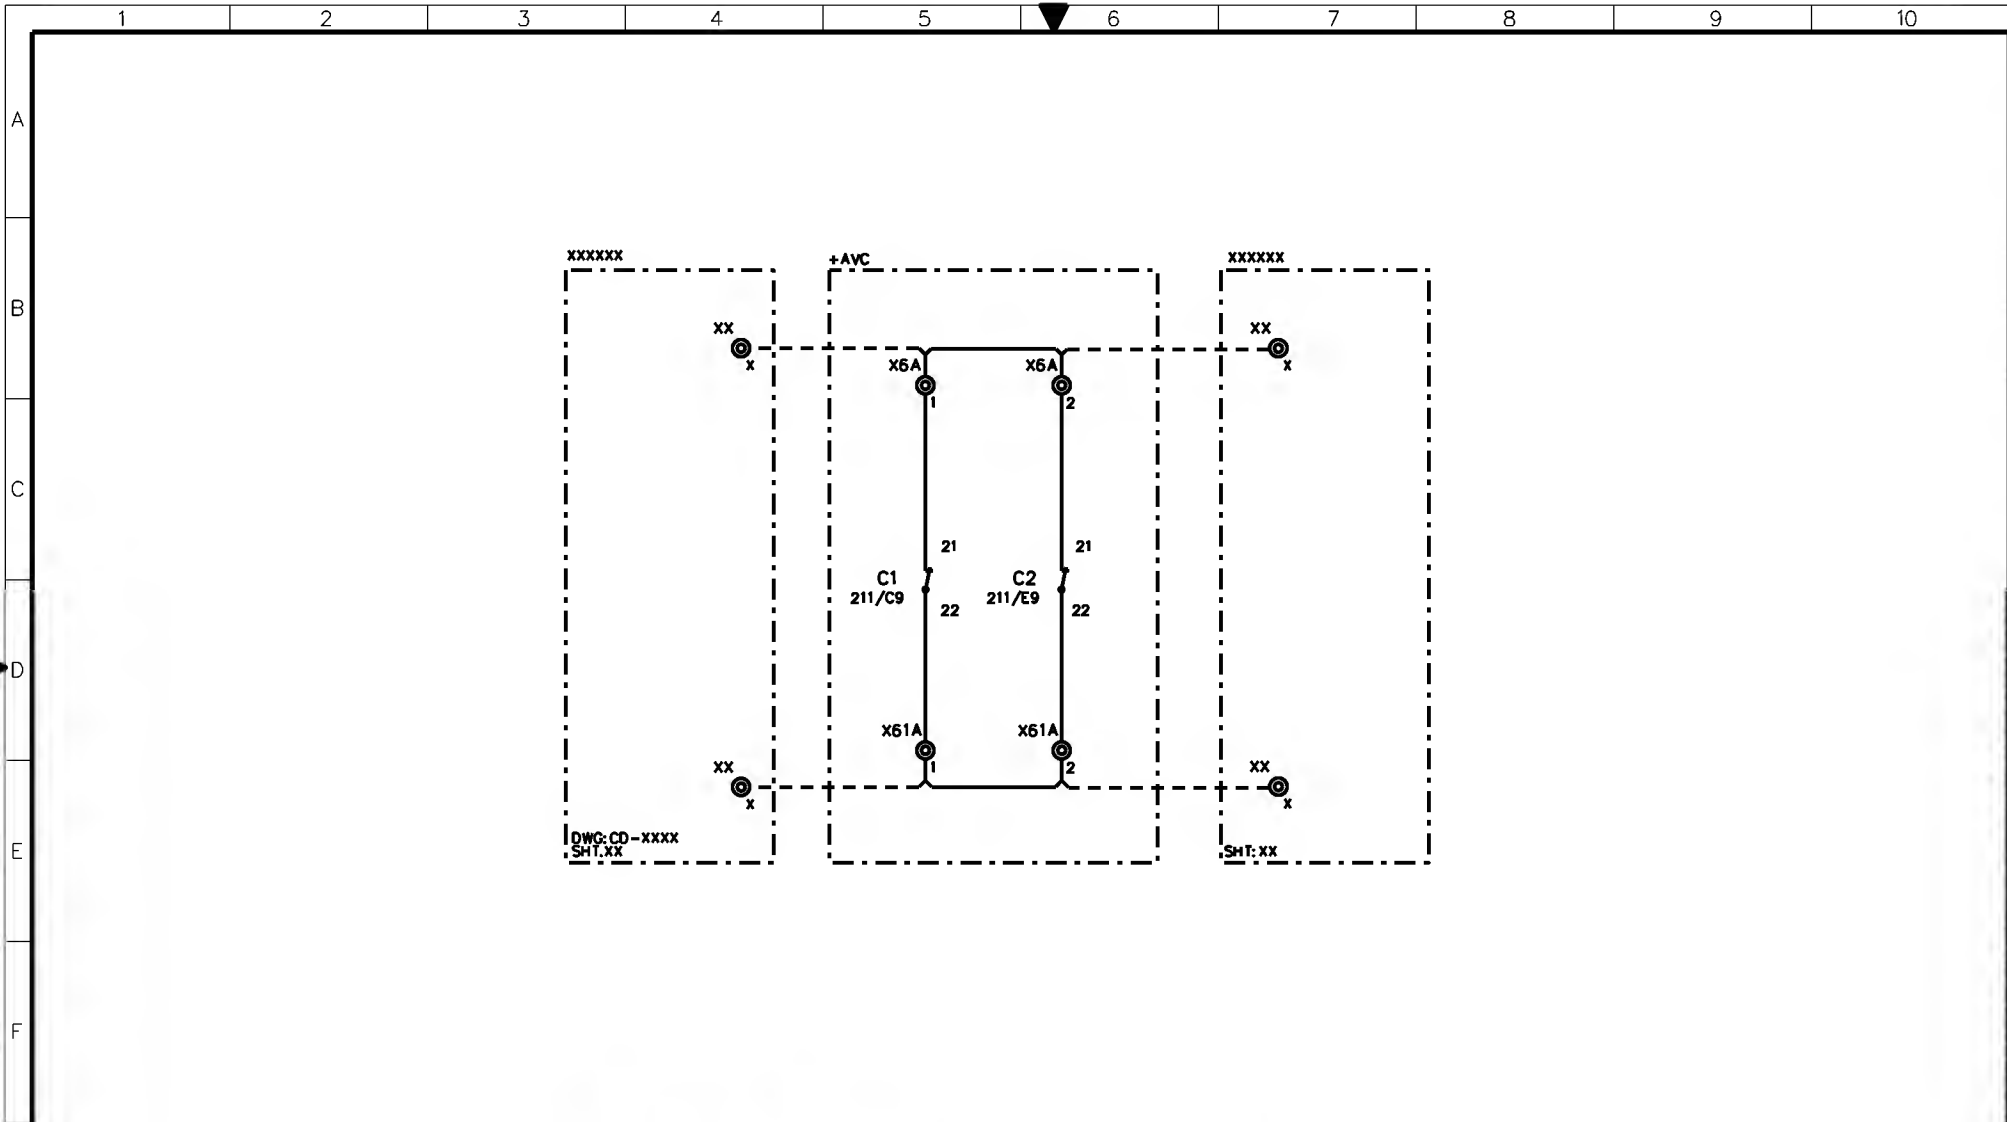


AS-BUILT BY _____ DATE _____ CONTRACT NO. 11131113/00 JOB ORDER NO. S-13020


02	13 49	FACTORY ASBUILT	DRAWN BY RIZ	CHECKED BY JKR
01	13 25	AS PER SEC COMMENT	DATE STARTED 04.02.2013	DATE COMPLETED
00	13 06	FOR APPROVAL	PRG. DEPT. CTPD	ENG. DEPT. AUT-PSAC
REV. NO.	DATE	DESCRIPTION		

CUB. LIGHTING, HEATER & SOCKET ALARM CKT.
132/13.8KV (GT1,GT2,GT3) AVC PANEL
S/S 8709 - 132/13.8KV IN AL-KHARJ CITY
RIYADH SAUDI ARABIA


الشركة الوطنية لنقل الكهرباء		نقل الكهرباء	
National Grid sa		National Grid sa	
INDEX	PLANT NO.	DRAWING NUMBER	SHEET NO.
-	C421	CD-322936	212
		CONT.	REV. NO.
		216	02

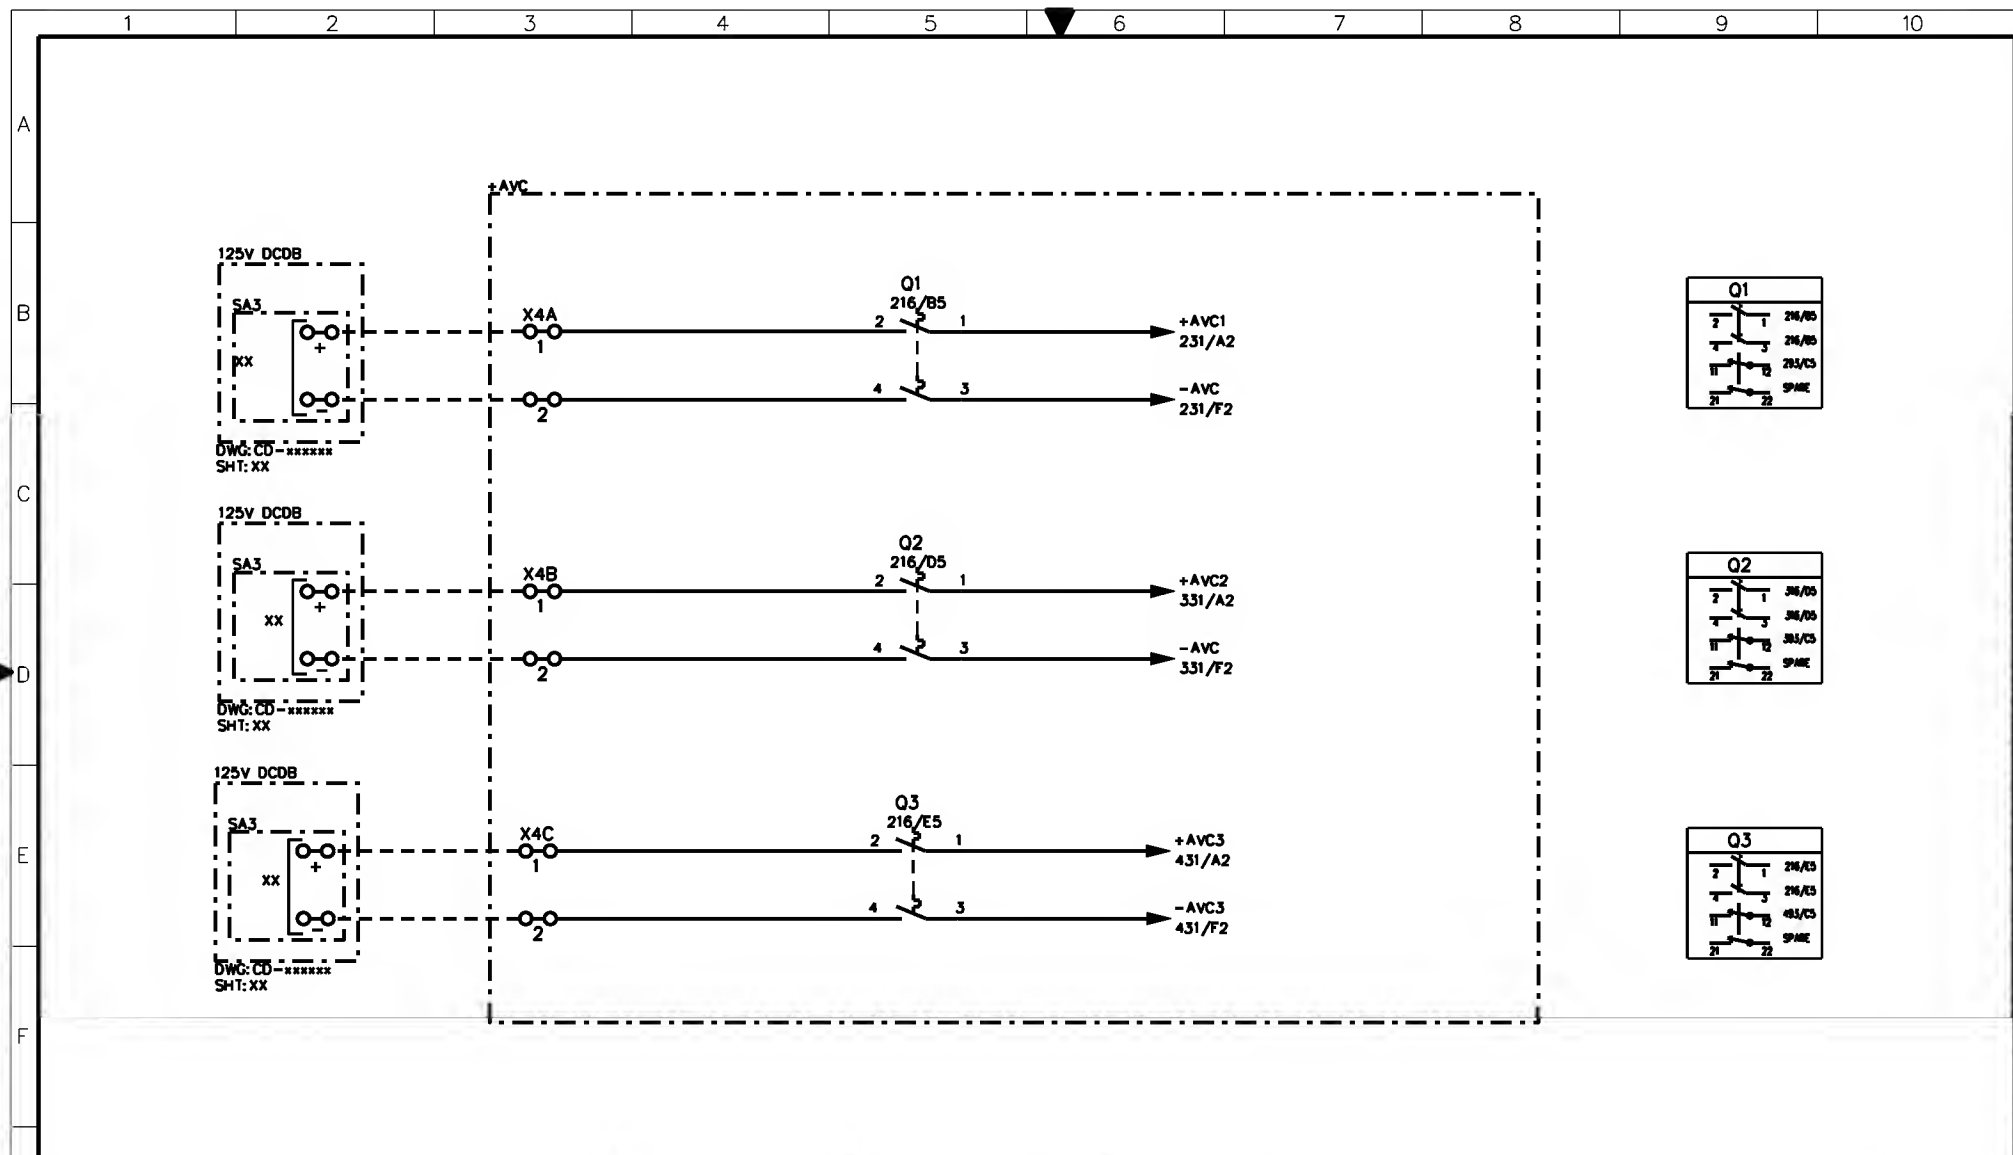


AS-BUILT BY _____ DATE _____			CONTRACT NO. 1113113/00		JOB ORDER NO. S-13020		DC SUPPLY DISTRIBUTION				نقل الكهرباء			
02	13	49	FACTORY ASBUILT		DRAWN BY RIZ CHECKED BY JKR		132/13.8KV (GT1,GT2,GT3) AVC PANEL				الشركة الوطنية لنقل الكهرباء			
01	13	25	AS PER SEC COMMENT		DATE STARTED 04.02.2013 DATE COMPLETED _____		S/S 8709 - 132/13.8KV IN AL-KHARJ CITY				National Grid sa			
00	13	06	FOR APPROVAL		OPRG. DEPT. CTPD ENG. DEPT. AUT-PSAC		RIYADH SAUDI ARABIA				INDEX PLANT NO. DRAWING NUMBER SHEET NO. REV. NO.			
REV. NO.	DATE		DESCRIPTION											

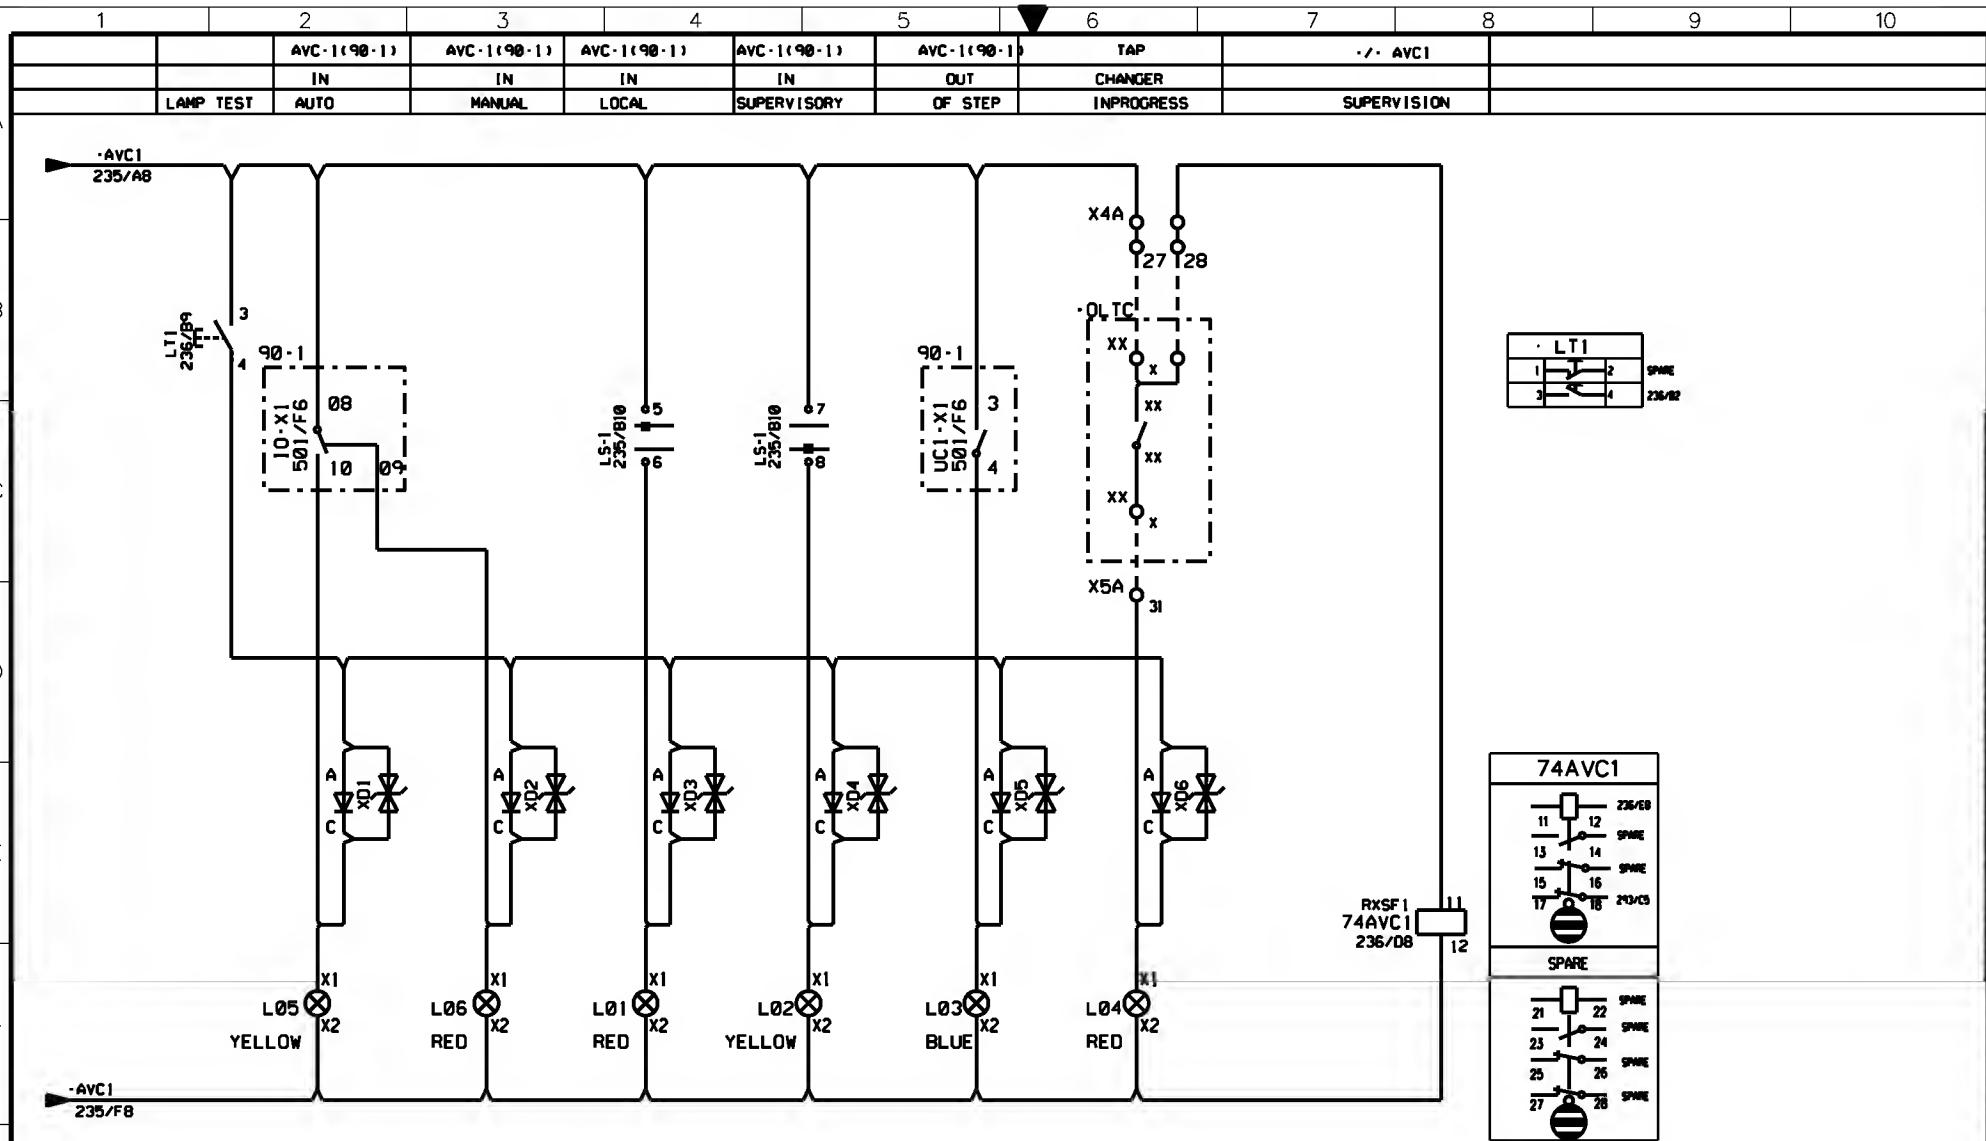

AS-BUILT BY _____ DATE _____			CONTRACT NO. 1113113/00		JOB ORDER NO. S-13020		INDICATION CIRCUIT-GT1			نقل الكهرباء الشركة الوطنية لنقل الكهرباء National Grid SA							
02	13	49	FACTORY ASBUILT		DRAWN BY RIZ CHECKED BY JKR		132/13.8KV (GT1,GT2,GT3) AVC PANEL			INDEX		PLANT NO.	DRAWING NUMBER		SHEET NO.		REV. NO.
01	13	25	AS PER SEC COMMENT		DATE STARTED 04.02.2013 DATE COMPLETED _____		S/S 8709 - 132/13.8KV IN AL-KHARJ CITY			-		C421	CD-322936		SHT. CONT.		02
00	13	06	FOR APPROVAL		ORIG. DEPT. CTPD ENG. DEPT. AUT-PSAC		RIYADH SAUDI ARABIA								236 237		
REV. NO.		DATE		DESCRIPTION													

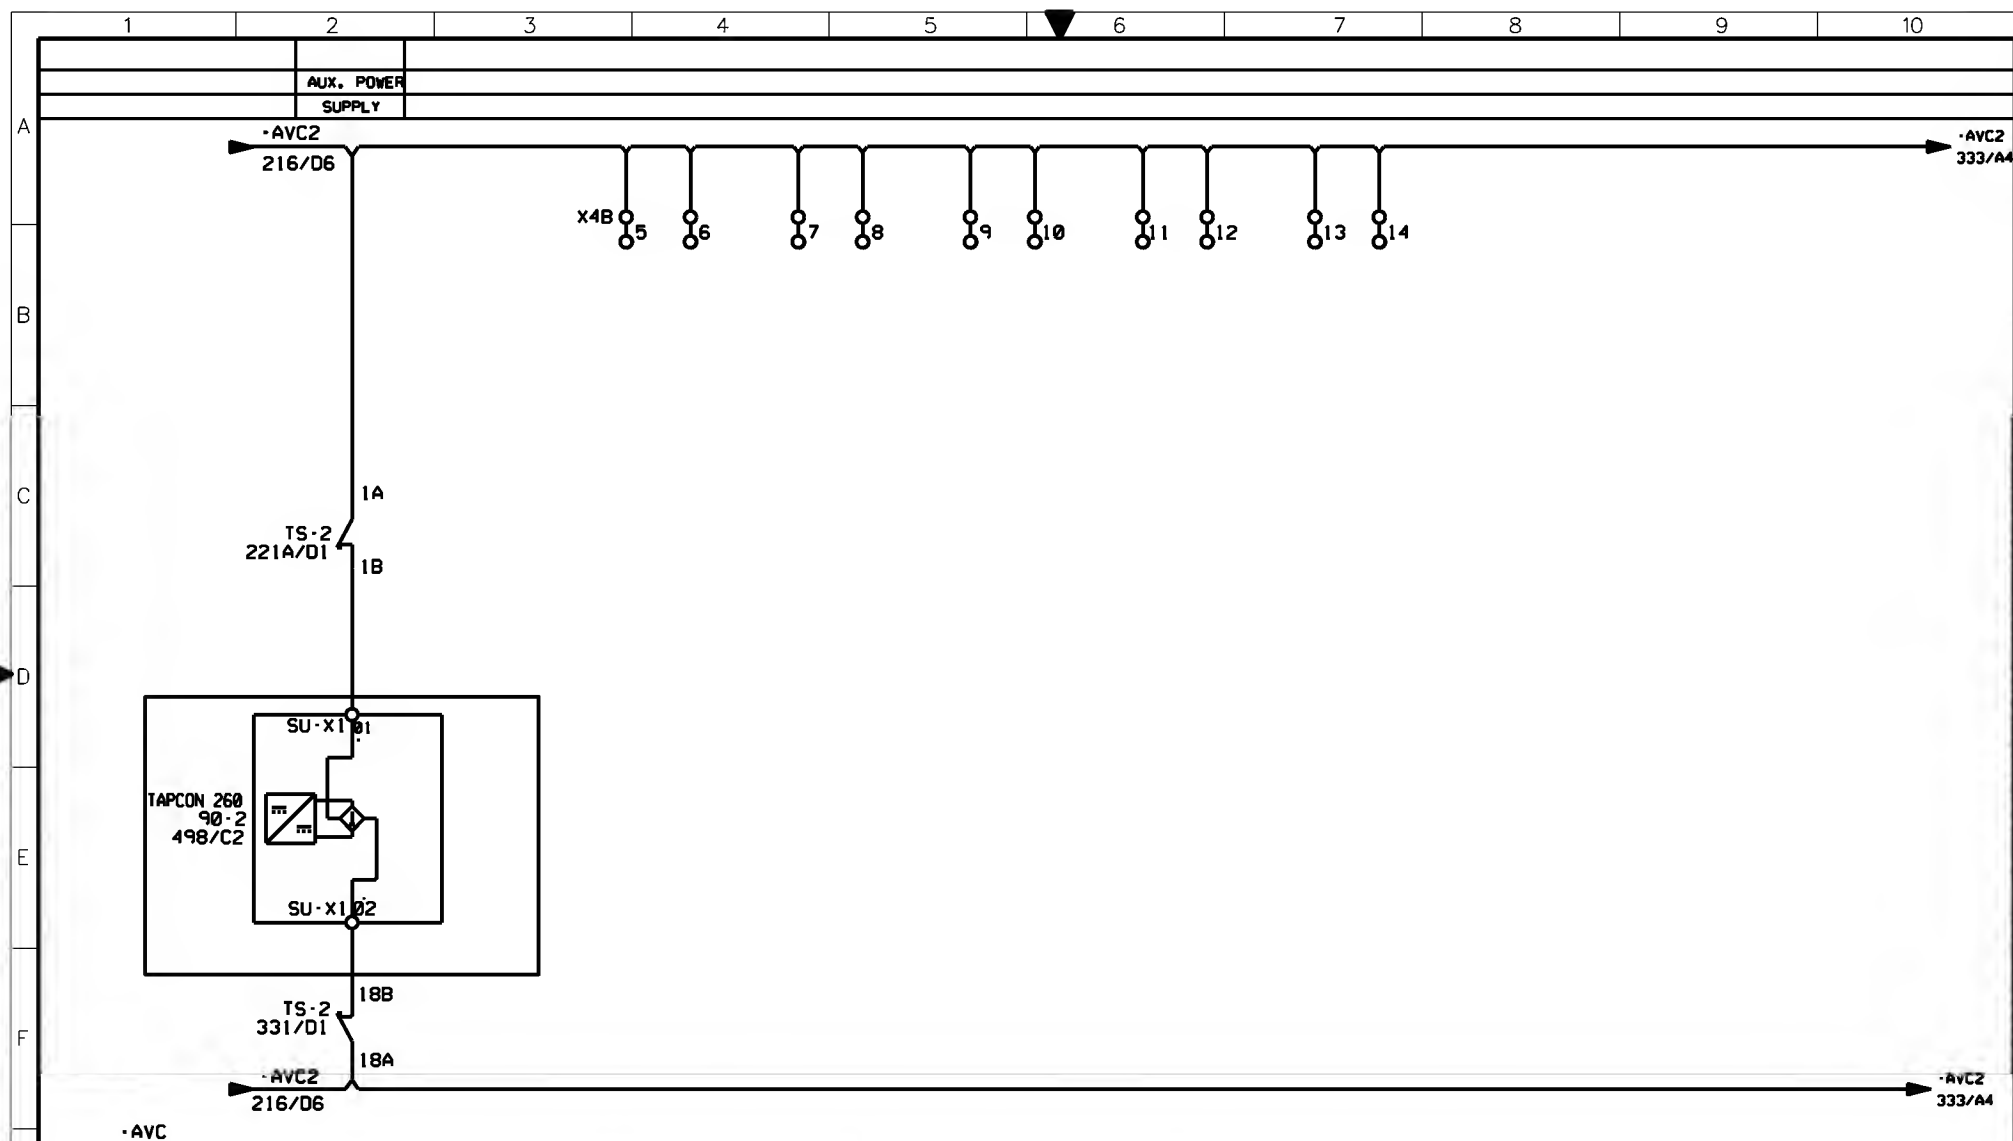

AS-BUILT BY _____ DATE _____			CONTRACT NO. 1113113/00		JOB ORDER NO. S-13020		BINARY INPUTS-GT2			الشركة الوطنية لنقل الكهرباء		نقل الكهرباء		National Grid sa	
02	13 49	FACTORY ASBUILT	DRAWN BY RIZ		CHECKED BY JKR		132/13.8KV (GT1,GT2,GT3) AVC PANEL			INDEX	PLANT NO.	DRAWING NUMBER		SHEET NO.	REV. NO.
01	13 25	AS PER SEC COMMENT	DATE STARTED 04.02.2013		DATE COMPLETED _____		S/S 8709 - 132/13.8KV IN AL-KHARJ CITY			-	C421	CD-322936		SHT 331	CONT. 333
00	13 06	FOR APPROVAL	OPRG. DEPT. CTPD		ENG. DEPT. AUT-PSAC		RIYADH SAUDI ARABIA								02
REV. NO.	DATE	DESCRIPTION													

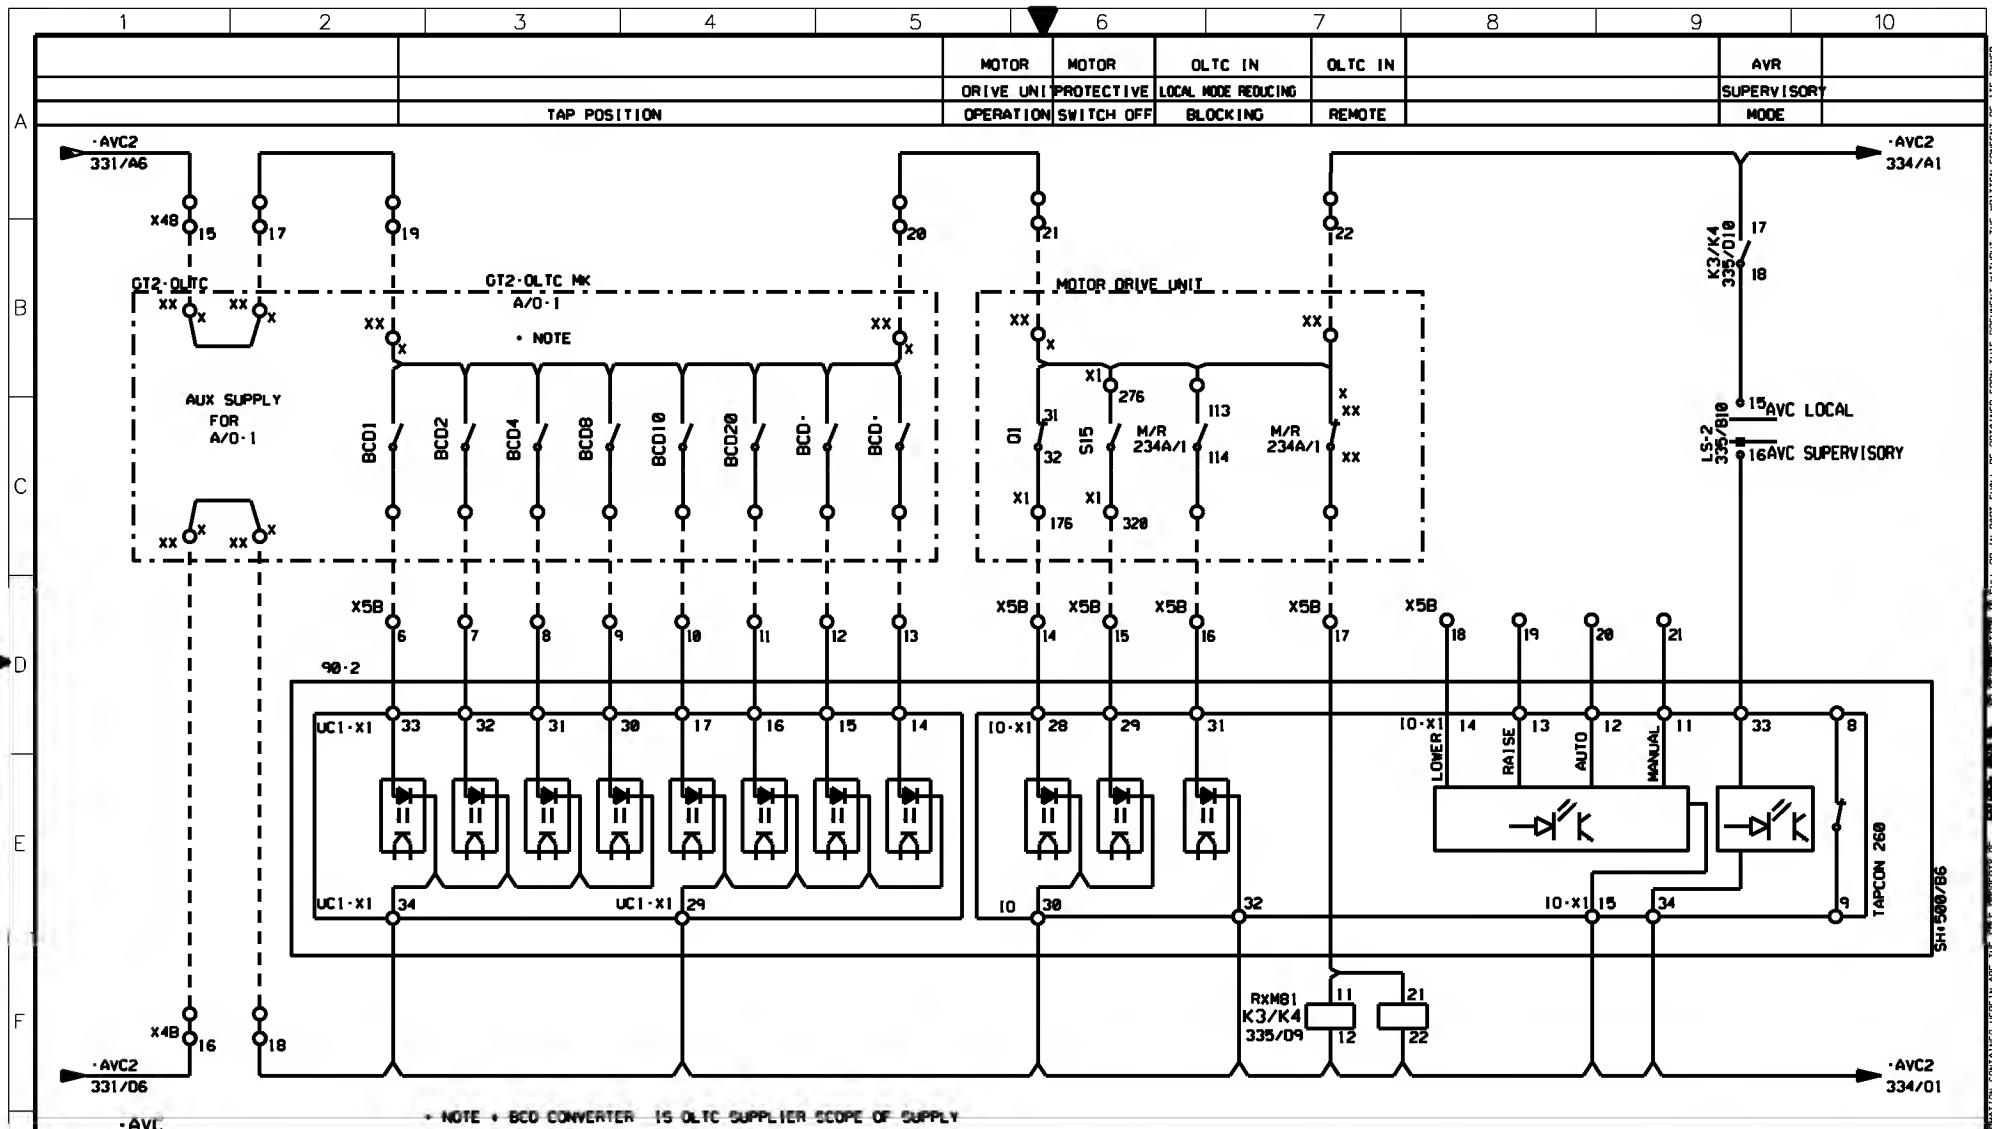

AS-BUILT BY _____ DATE _____ CONTRACT NO. 11131113/00 JOB ORDER NO. S-13020

02	13 49	FACTORY ASBUILT
01	13 25	AS PER SEC COMMENT
00	13 06	FOR APPROVAL
REV. NO.	DATE	DESCRIPTION


DRAWN BY RIZ CHECKED BY JKR
 DATE STARTED 04.02.2013 DATE COMPLETED _____
 PRG. DEPT. CTPD ENG. DEPT. AUT-PSAC

BINARY INPUTS-GT2
132/13.8KV (GT1,GT2,GT3) AVC PANEL
S/S 8709 - 132/13.8KV IN AL-KHARJ CITY
RIYADH SAUDI ARABIA

الشركة الوطنية لنقل الكهرباء		National Grid SA	
INDEX	PLANT NO.	DRAWING NUMBER	SHEET NO.
-	C421	CD-322936	333
			REV. NO.
			02

NG/D2-D (2012/01)

DMS VECTOR NGD200

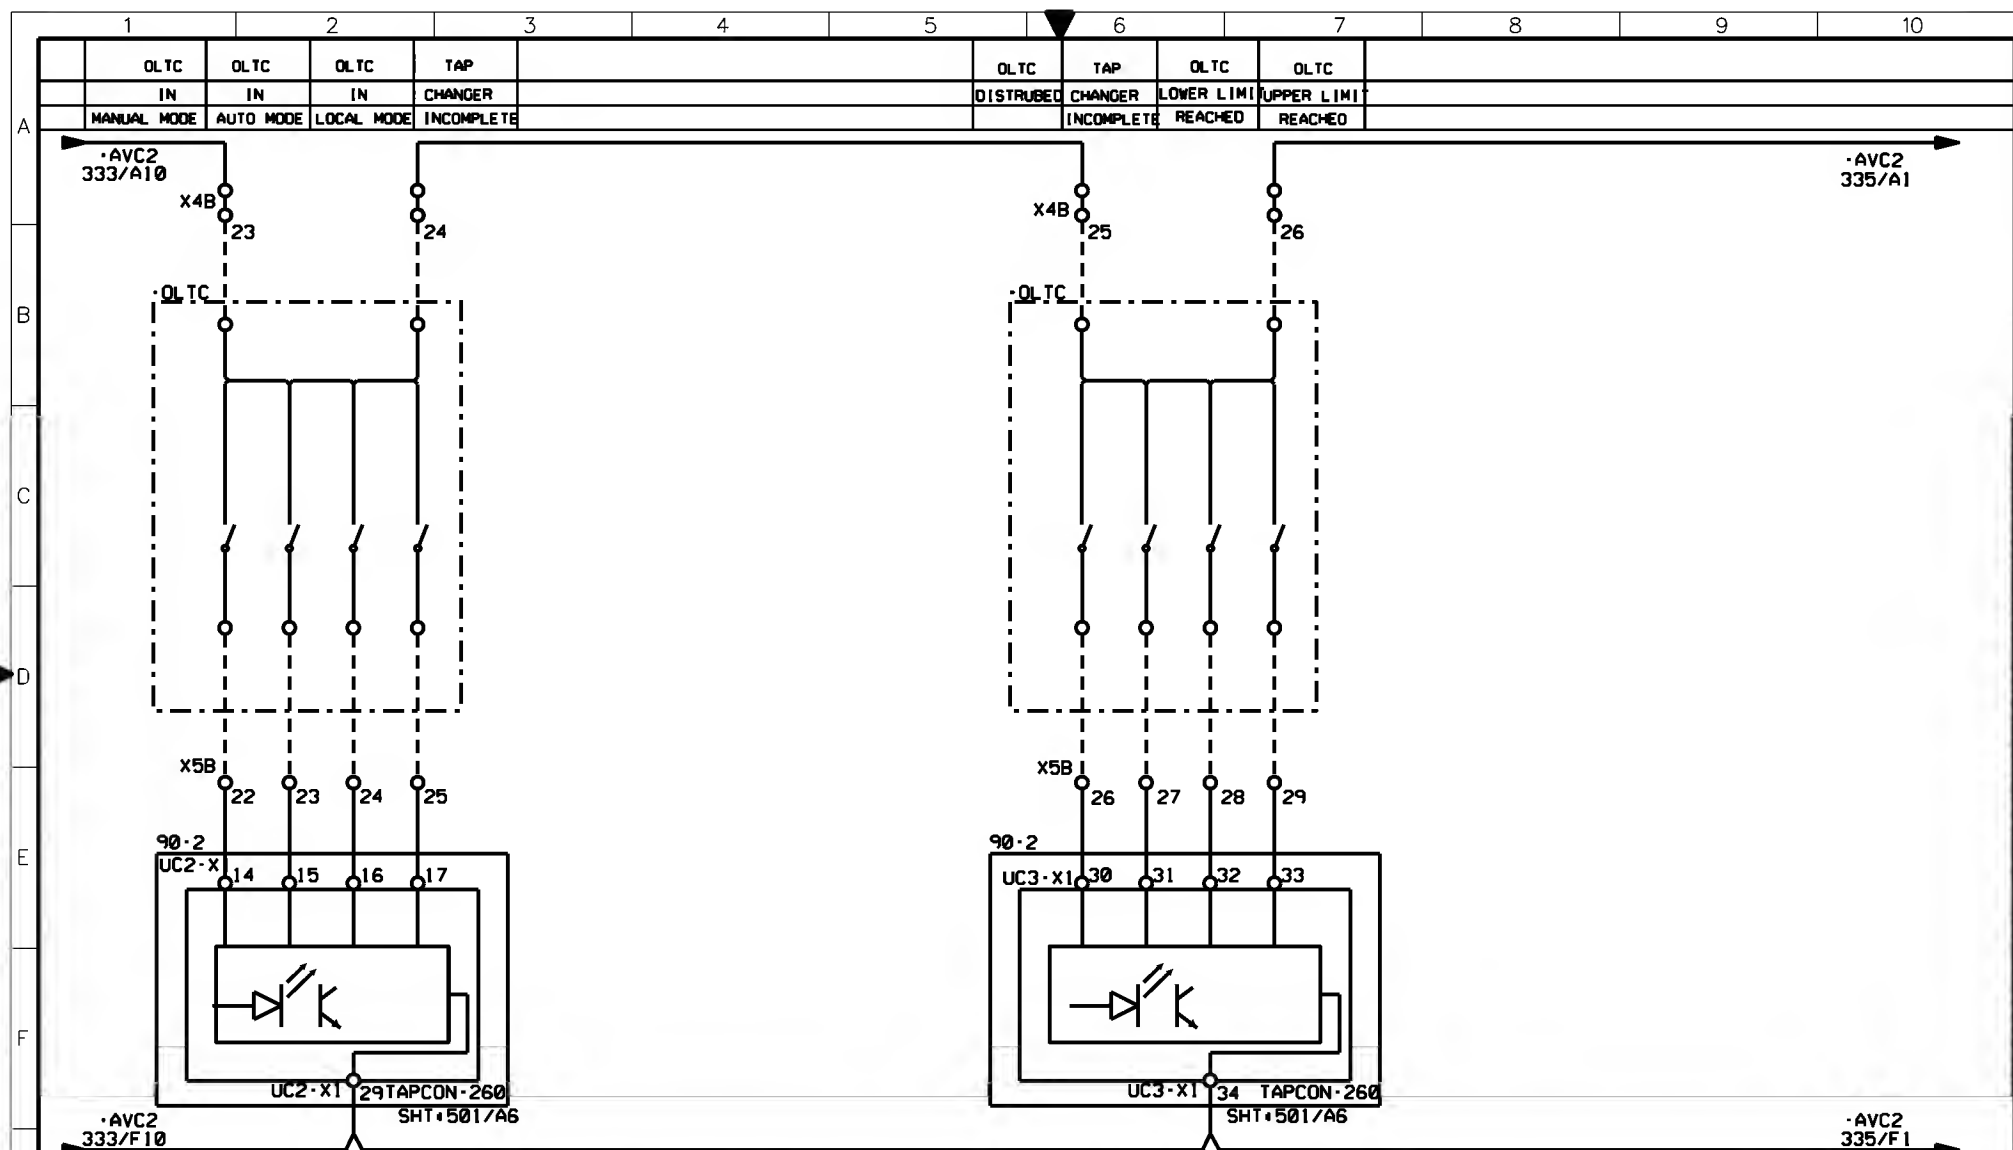

AS-BUILT BY

DATE

CONTRACT NO. 11131113/00

JOB ORDER NO. S-13020

02

13 49

FACTORY ASBUILT

01

13 25

AS PER SEC COMMENT

00

13 06

FOR APPROVAL

REV. NO.

DATE

DESCRIPTION

DRAWN BY RIZ

CHECKED BY JKR

DATE STARTED 04.02.2013

DATE COMPLETED

OPRG. DEPT. CTPD

ENG. DEPT. AUT-PSAC

BINARY INPUTS-GT2

132/13.8KV (GT1,GT2,GT3) AVC PANEL

S/S 8709 - 132/13.8KV IN AL-KHARJ CITY

RIYADH SAUDI ARABIA

نقل الكهرباء

الشركة الوطنية لنقل الكهرباء

National Grid sa

INDEX

PLANT NO.

DRAWING NUMBER

SHEET NO.

REV. NO.

-


C421

CD-322936

SHT 334

CONT. 335

02

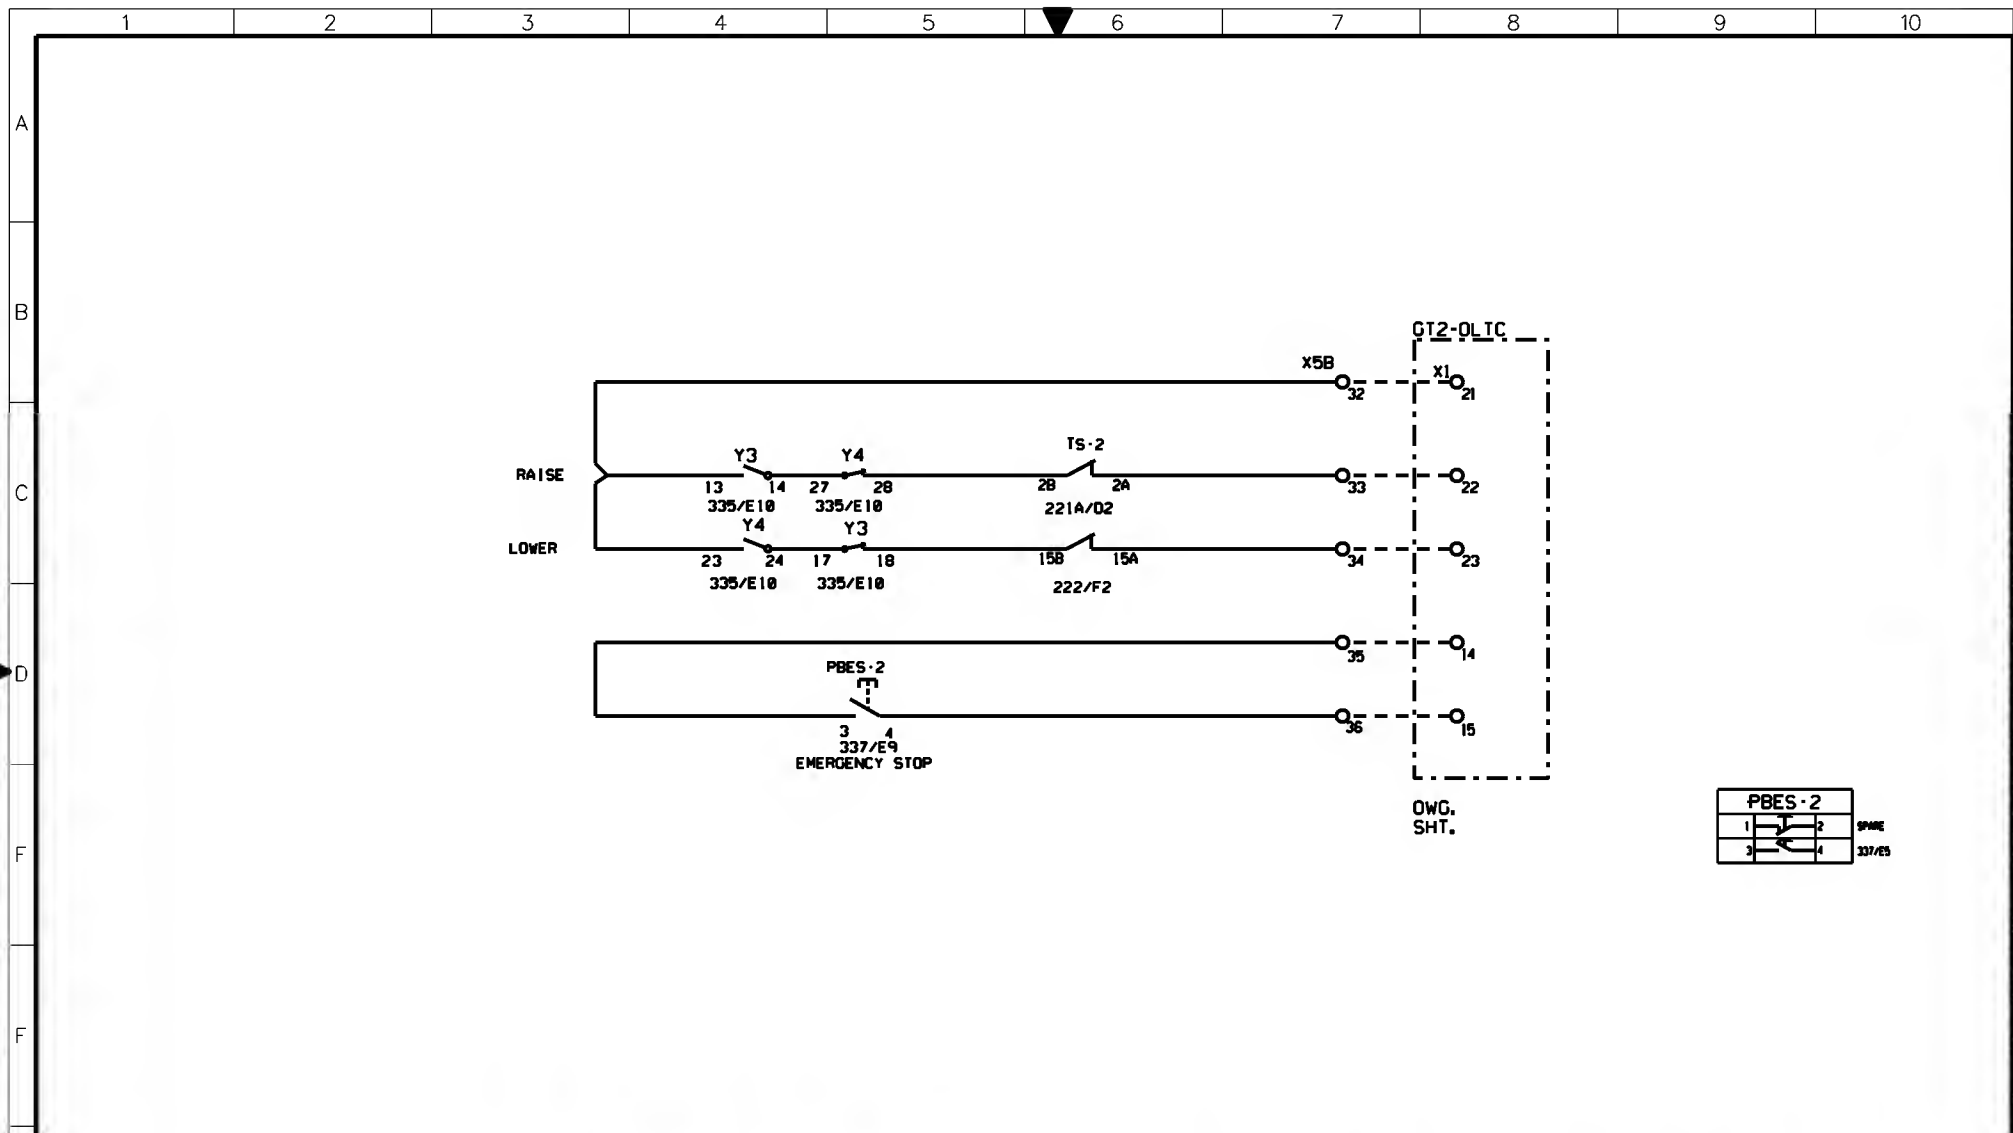


PBES-2			
1	2	3	4
1	2	3	4

AS-BUILT BY _____ DATE _____ CONTRACT NO. **11131113/00** JOB ORDER NO. **S-13020**


02	13 49	FACTORY ASBUILT	DRAWN BY RIZ CHECKED BY JKR
01	13 25	AS PER SEC COMMENT	DATE STARTED 04.02.2013 DATE COMPLETED _____
00	13 06	FOR APPROVAL	OPRG. DEPT. CTPD ENG. DEPT. AUT-PSAC
REV. NO.	DATE	DESCRIPTION	


TAP CHANGER RAISE/LOWER CIRCUITS
132/13.8KV (GT1,GT2,GT3) AVC PANEL
S/S 8709 - 132/13.8KV IN AL-KHARJ CITY
RIYADH SAUDI ARABIA


الشركة الوطنية لنقل الكهرباء				National Grid sa	
INDEX	PLANT NO.	DRAWING NUMBER	SHEET NO.	REV. NO.	
-	C421	CD-322936	337/393	02	

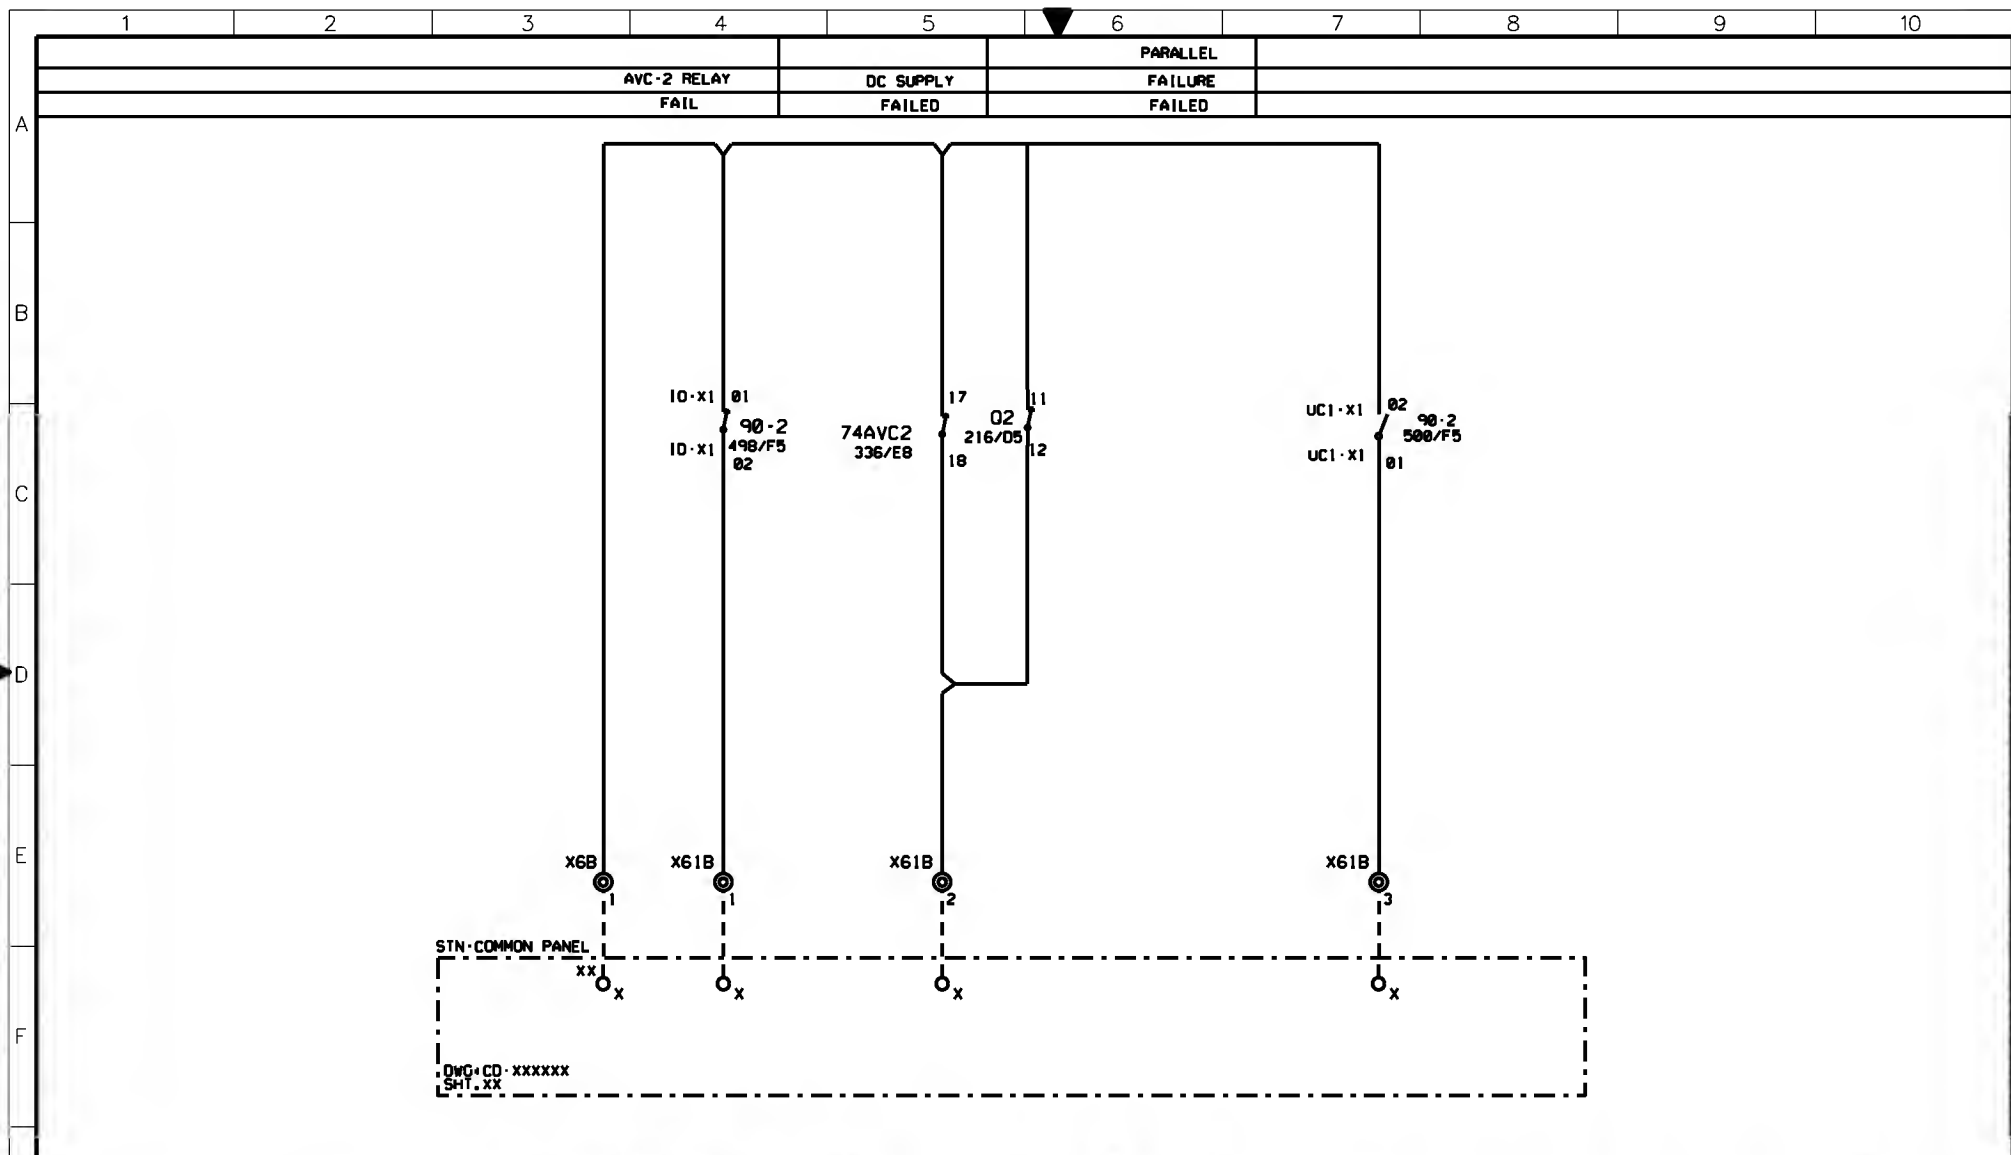

AS-BUILT BY _____ DATE _____			CONTRACT NO. 1113113/00		JOB ORDER NO. S-13020		STN-COMMON ALARM CIRCUIT				نقل الكهرباء الشركة الوطنية لنقل الكهرباء National Grid sa			
02 13 49			FACTORY ASBUILT		DRAWN BY RIZ CHECKED BY JKR		132/13.8KV (GT1,GT2,GT3) AVC PANEL				INDEX PLANT NO. DRAWING NUMBER SHEET NO. REV. NO.			
01 13 25			AS PER SEC COMMENT		DATE STARTED 04.02.2013 DATE COMPLETED _____		S/S 8709 - 132/13.8KV IN AL-KHARJ CITY				- C421 CD-322936 393 431 02			
00 13 06			FOR APPROVAL		OPRG. DEPT. CTPD ENG. DEPT. AUT-PSAC		RIYADH SAUDI ARABIA							
REV. NO. DATE DESCRIPTION														

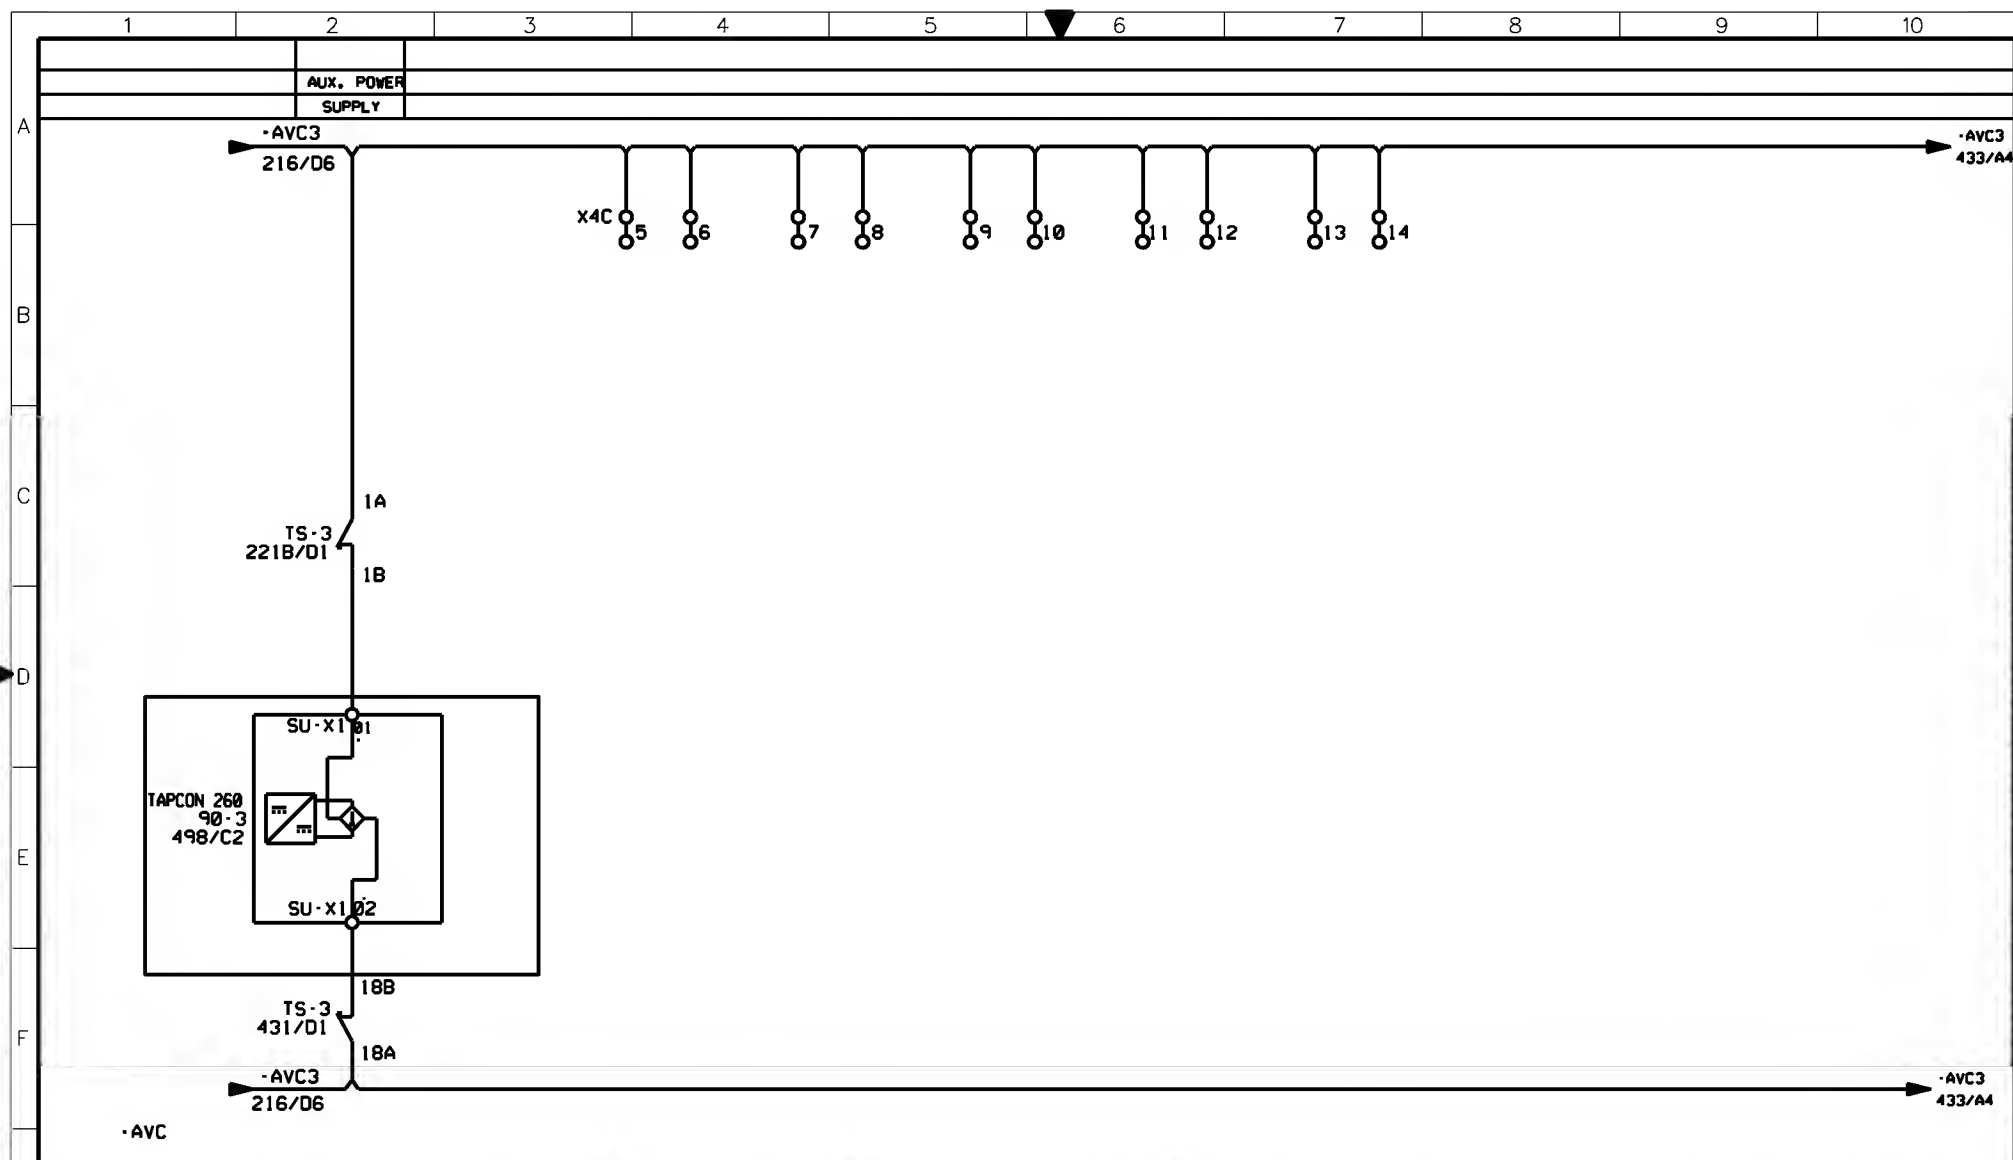

AS-BUILT BY _____ DATE _____			CONTRACT NO. 11131113/00		JOB ORDER NO. S-13020		BINARY INPUTS-GT3				الشركة الوطنية لنقل الكهرباء						نقل الكهرباء					
FACTORY ASBUILT			DRAWN BY RIZ		CHECKED BY JKR		132/13.8KV (GT1,GT2,GT3) AVC PANEL				INDEX				PLANT NO.		DRAWING NUMBER		SHEET NO.		REV. NO.	
AS PER SEC COMMENT			DATE STARTED 04.02.2013		DATE COMPLETED _____		S/S 8709 - 132/13.8KV IN AL-KHARJ CITY				-				C421		CD-322936		SHT 431		CONT. 433	
FOR APPROVAL			OPRG. DEPT. CTPD		ENG. DEPT. AUT-PSAC		RIYADH														02	
DESCRIPTION							SAUDI ARABIA															

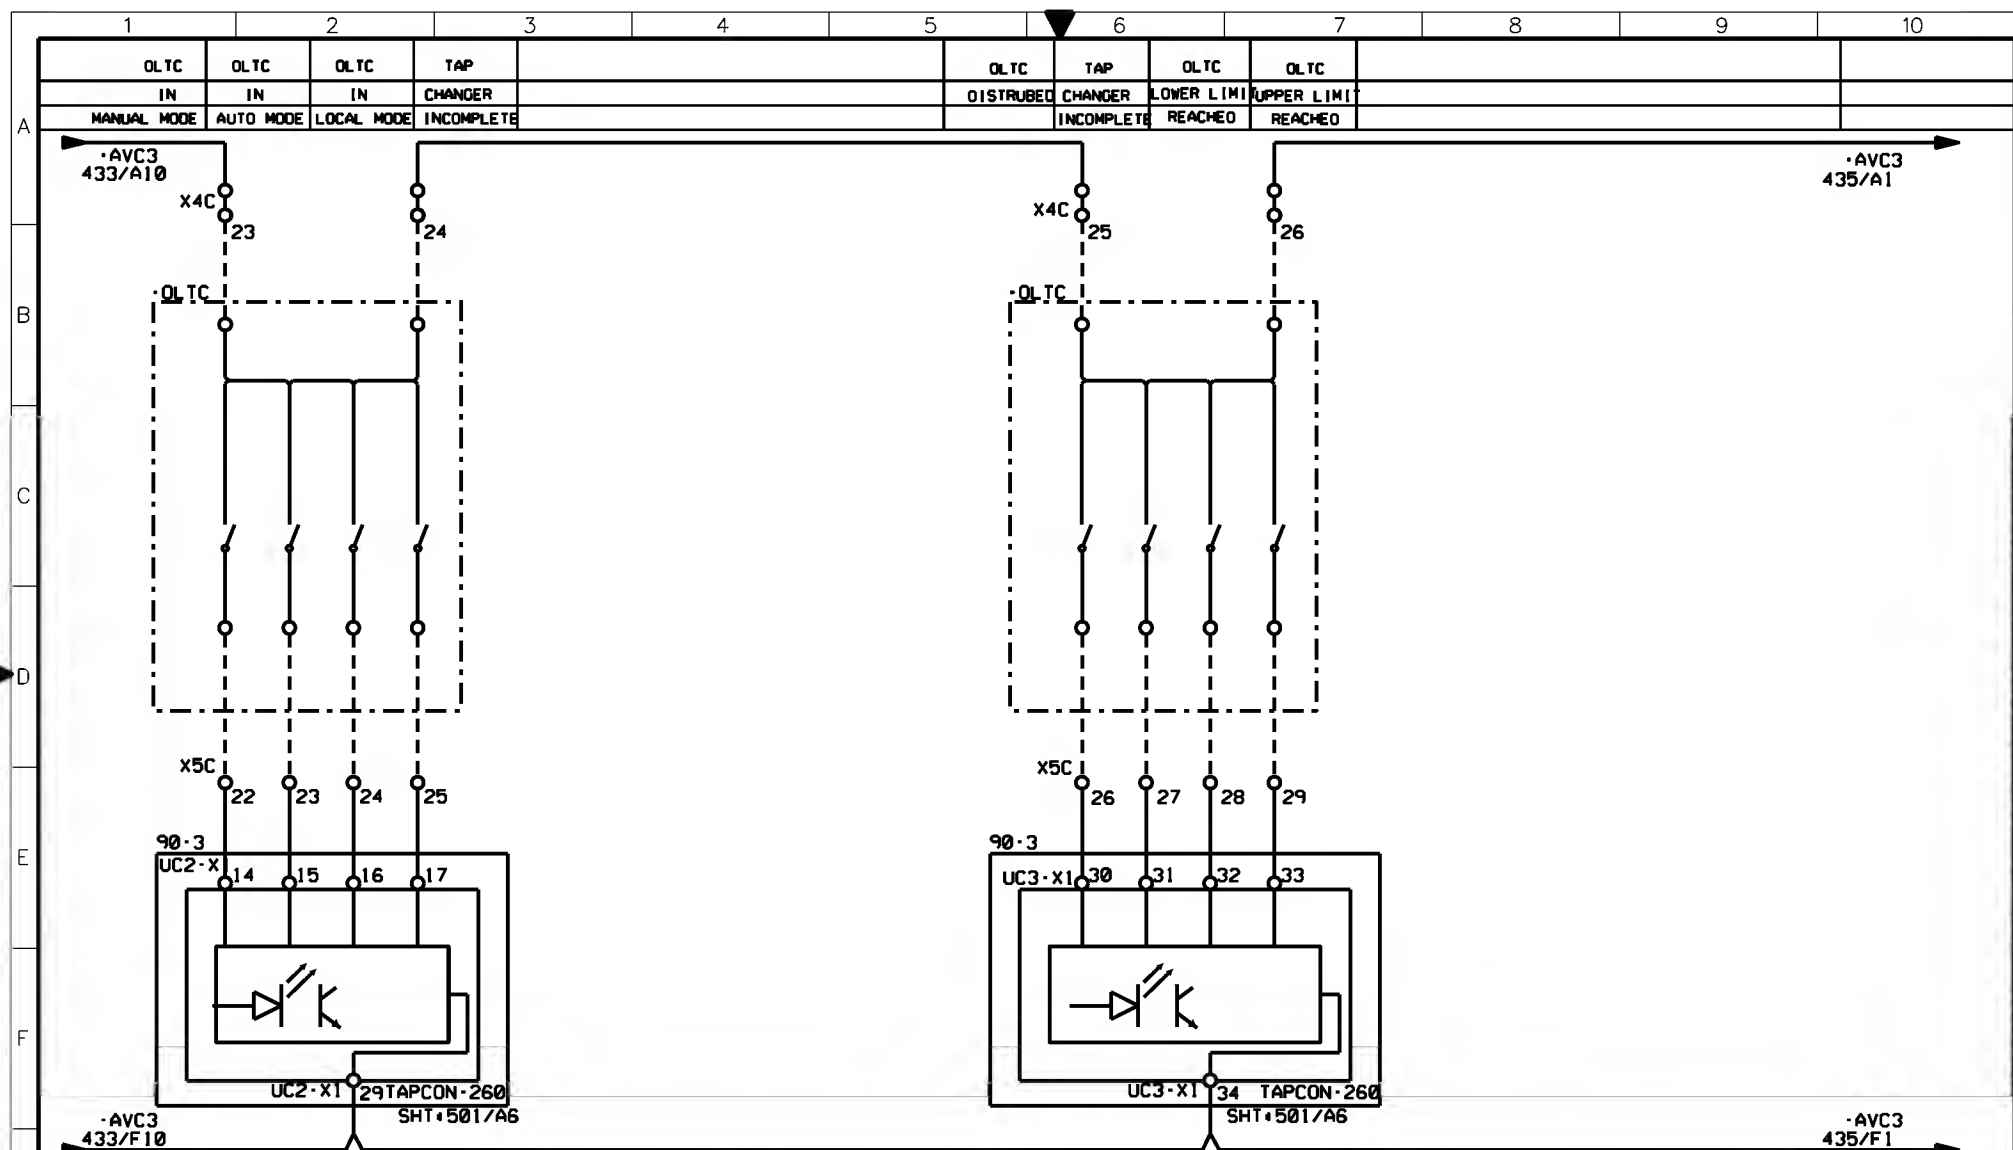

AS-BUILT BY

DATE

CONTRACT NO. 11131113/00

JOB ORDER NO. S-13020

021349

FACTORY ASBUILT

011325

AS PER SEC COMMENT

001306

FOR APPROVAL

REV. NO.

DATE

DESCRIPTION

DRAWN BY RIZ

CHECKED BY JKR

DATE STARTED 04.02.2013

DATE COMPLETED

OPRG. DEPT. CTPD

ENG. DEPT. AUT-PSAC

BINARY INPUTS-GT3

132/13.8KV (GT1,GT2,GT3) AVC PANEL

S/S 8709 - 132/13.8KV IN AL-KHARJ CITY

RIYADH

SAUDI ARABIA

الشركة الوطنية لنقل الكهرباء

نقل الكهرباء

National Grid sa

INDEX

PLANT NO.

DRAWING NUMBER

SHEET NO.

REV. NO.


-

C421



CD-322936

434435



02

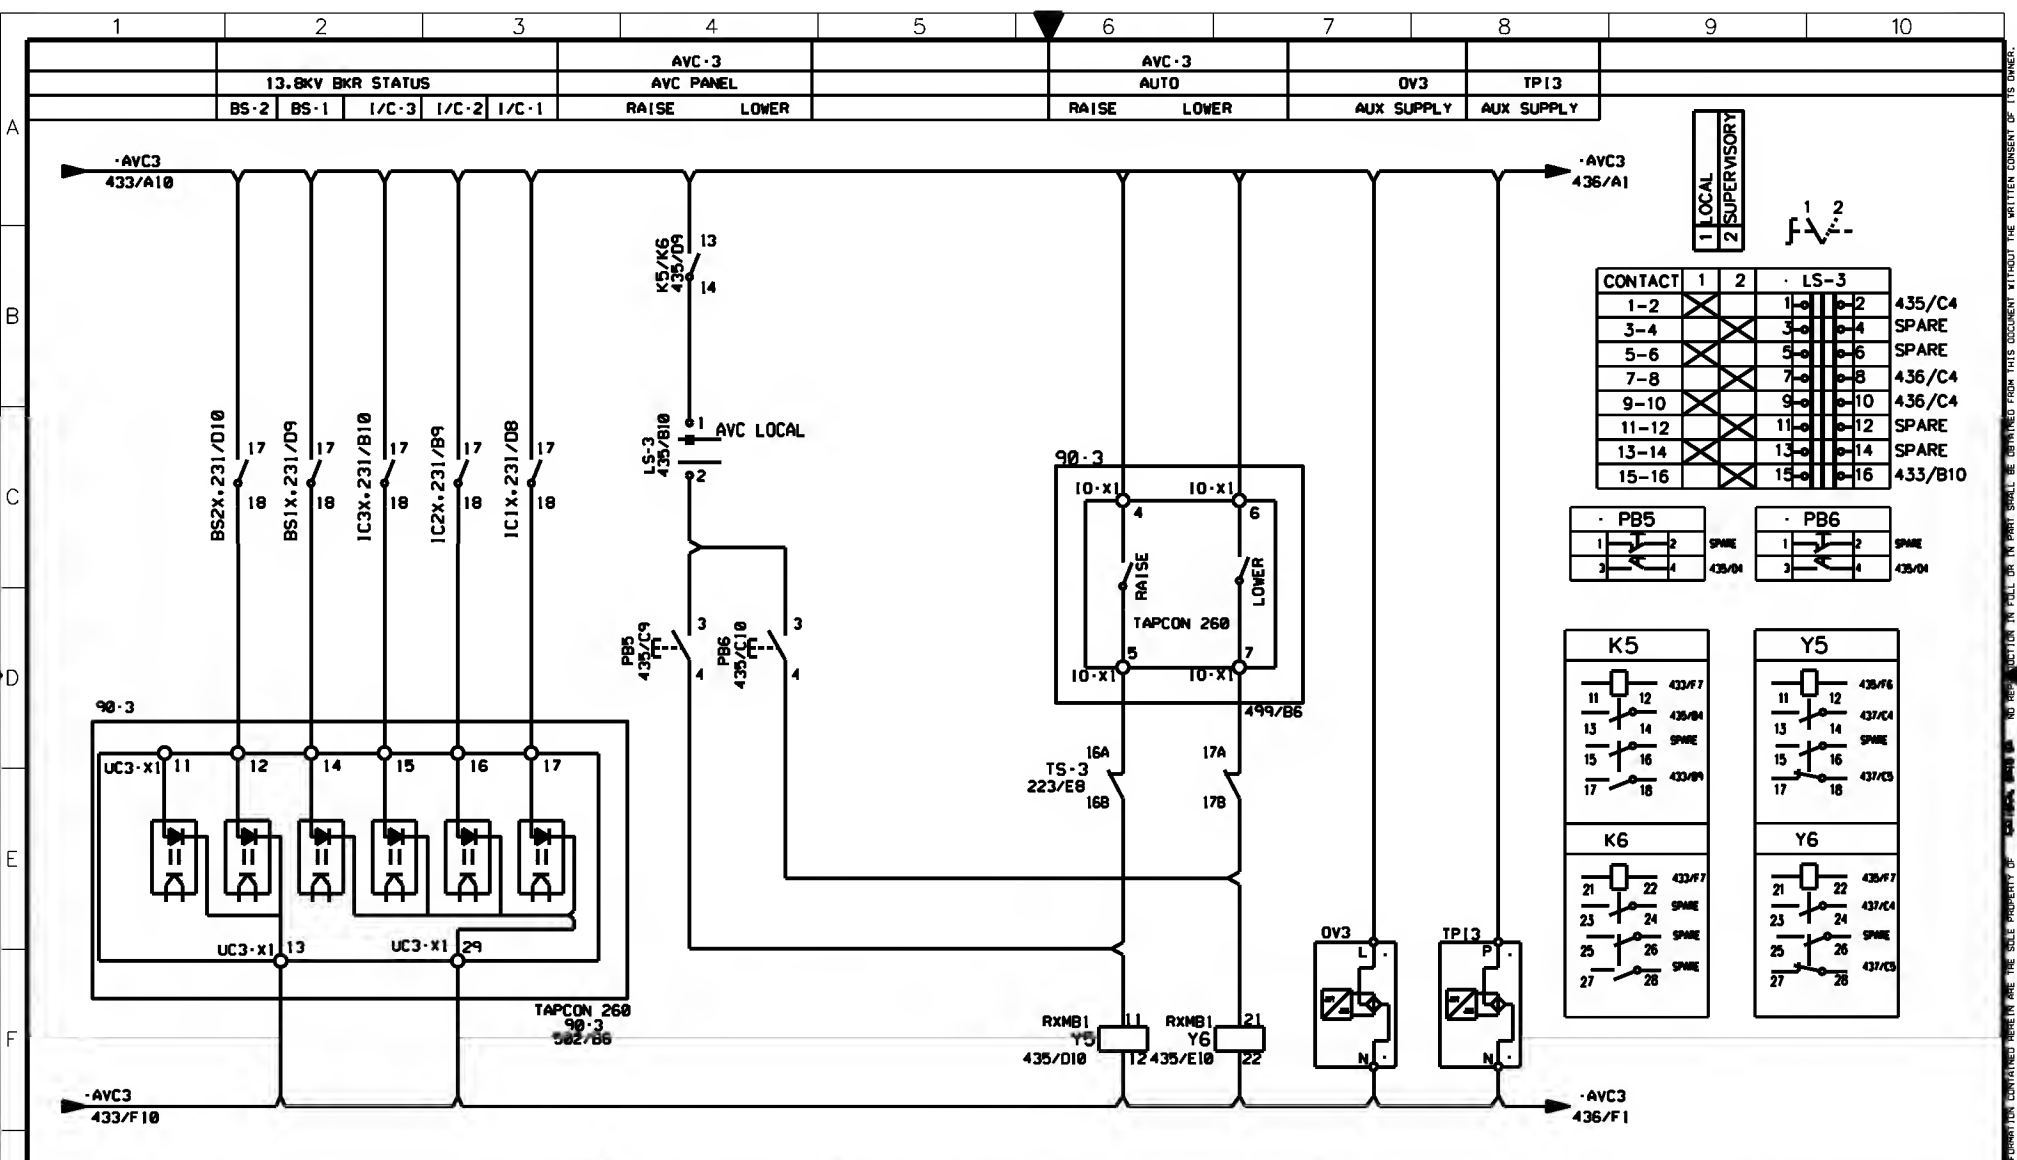

AS-BUILT BY _____ DATE _____			CONTRACT NO. 1113113/00		JOB ORDER NO. S-13020		TAP CHANGER RAISE/LOWER CIRCUITS			نقل الكهرباء الشركة الوطنية لنقل الكهرباء National Grid SA			
02	13	49	FACTORY ASBUILT AS PER SEC COMMENT FOR APPROVAL		DRAWN BY RIZ CHECKED BY JKR		132/13.8KV (GT1,GT2,GT3) AVC PANEL			INDEX PLANT NO. DRAWING NUMBER SHEET NO. REV. NO. - C421 CD-322936 435 436 02			
01	13	25			DATE STARTED 04.02.2013 DATE COMPLETED _____		S/S 8709 - 132/13.8KV IN AL-KHARJ CITY						
00	13	06			ORFG. DEPT. CTPD ENG. DEPT. AUT-PSAC		RIYADH SAUDI ARABIA						
REV. NO.	DATE		DESCRIPTION										

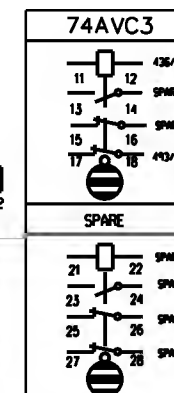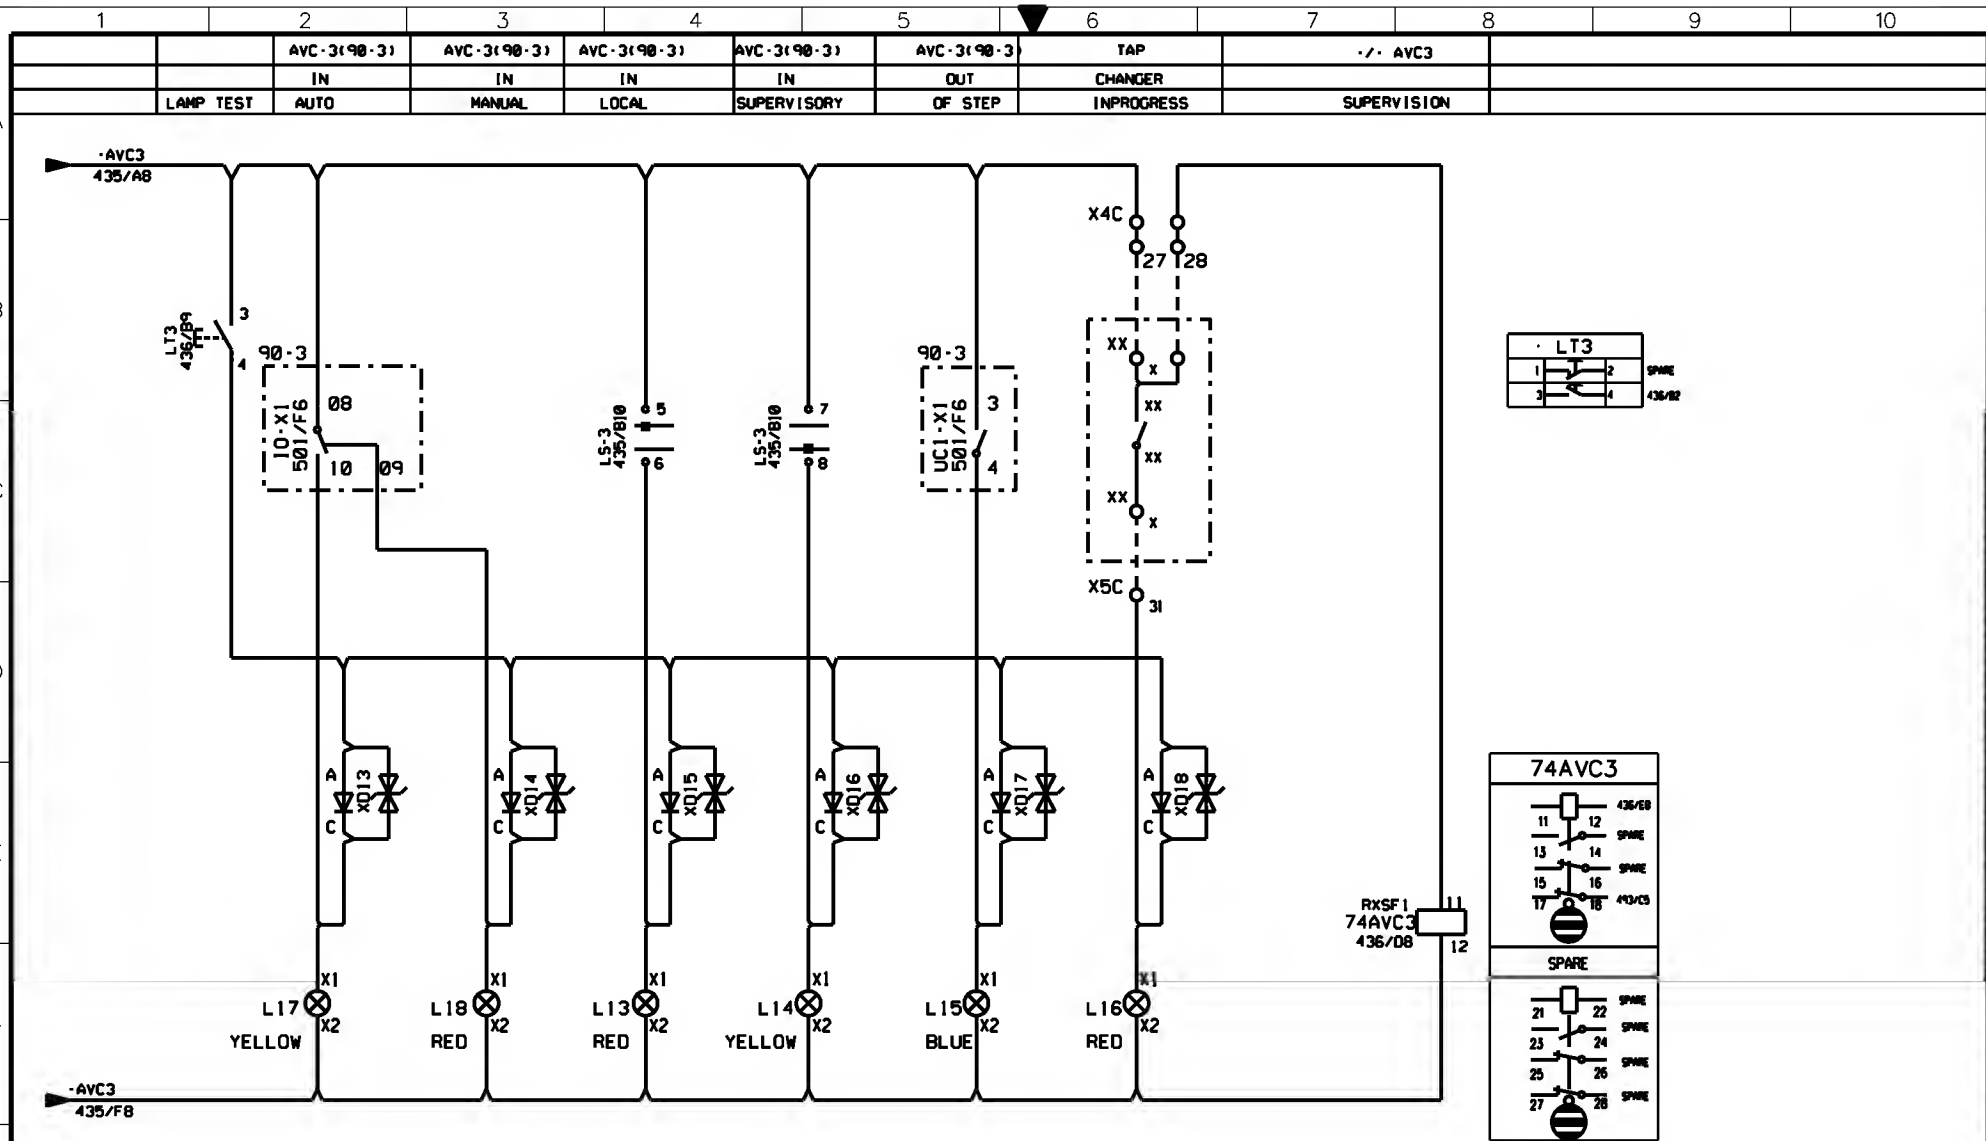

AS-BUILT BY _____ DATE _____			CONTRACT NO. 1113113/00		JOB ORDER NO. S-13020		INDICATION CIRCUIT-GT3			الشركة الوطنية لنقل الكهرباء		
02	13	49	FACTORY ASBUILT			DRAWN BY RIZ	CHECKED BY JKR	132/13.8KV (GT1,GT2,GT3) AVC PANEL			National Grid SA	
01	13	25	AS PER SEC COMMENT			DATE STARTED 04.02.2013			S/S 8709 - 132/13.8KV IN AL-KHARJ CITY			INDEX
00	13	06	FOR APPROVAL			DATE COMPLETED _____			RIYADH SAUDI ARABIA			PLANT NO.
REV. NO.	DATE	DESCRIPTION	ORIG. DEPT. CTPD			ENG. DEPT. AUT-PSAC			CD-322936			DRAWING NUMBER
									436 437			SHEET NO.
									02			REV. NO.

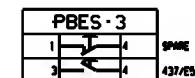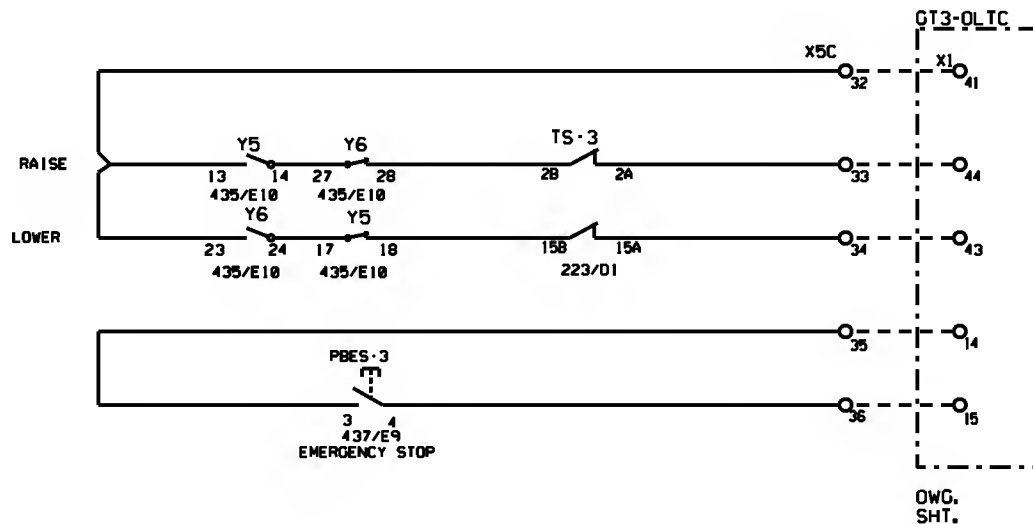


AS-BUILT BY _____ DATE _____ CONTRACT NO. **11131113/00** JOB ORDER NO. **S-13020**


02	13 49	FACTORY ASBUILT
01	13 25	AS PER SEC COMMENT
00	13 06	FOR APPROVAL
REV. NO.	DATE	DESCRIPTION


DRAWN BY	RIZ	CHECKED BY	JKR
DATE STARTED	04.02.2013	DATE COMPLETED	
OPRG. DEPT.	CTPD	ENG. DEPT.	AUT-PSAC

TAP CHANGER RAISE/LOWER CIRCUITS
132/13.8KV (GT1,GT2,GT3) AVC PANEL
S/S 8709 - 132/13.8KV IN AL-KHARJ CITY
RIYADH SAUDI ARABIA

الشركة الوطنية لنقل الكهرباء		نقل الكهرباء	
		National Grid sa	
INDEX	PLANT NO.	DRAWING NUMBER	SHEET NO.
-	C421	CD-322936	437/493
			REV. NO.
			02

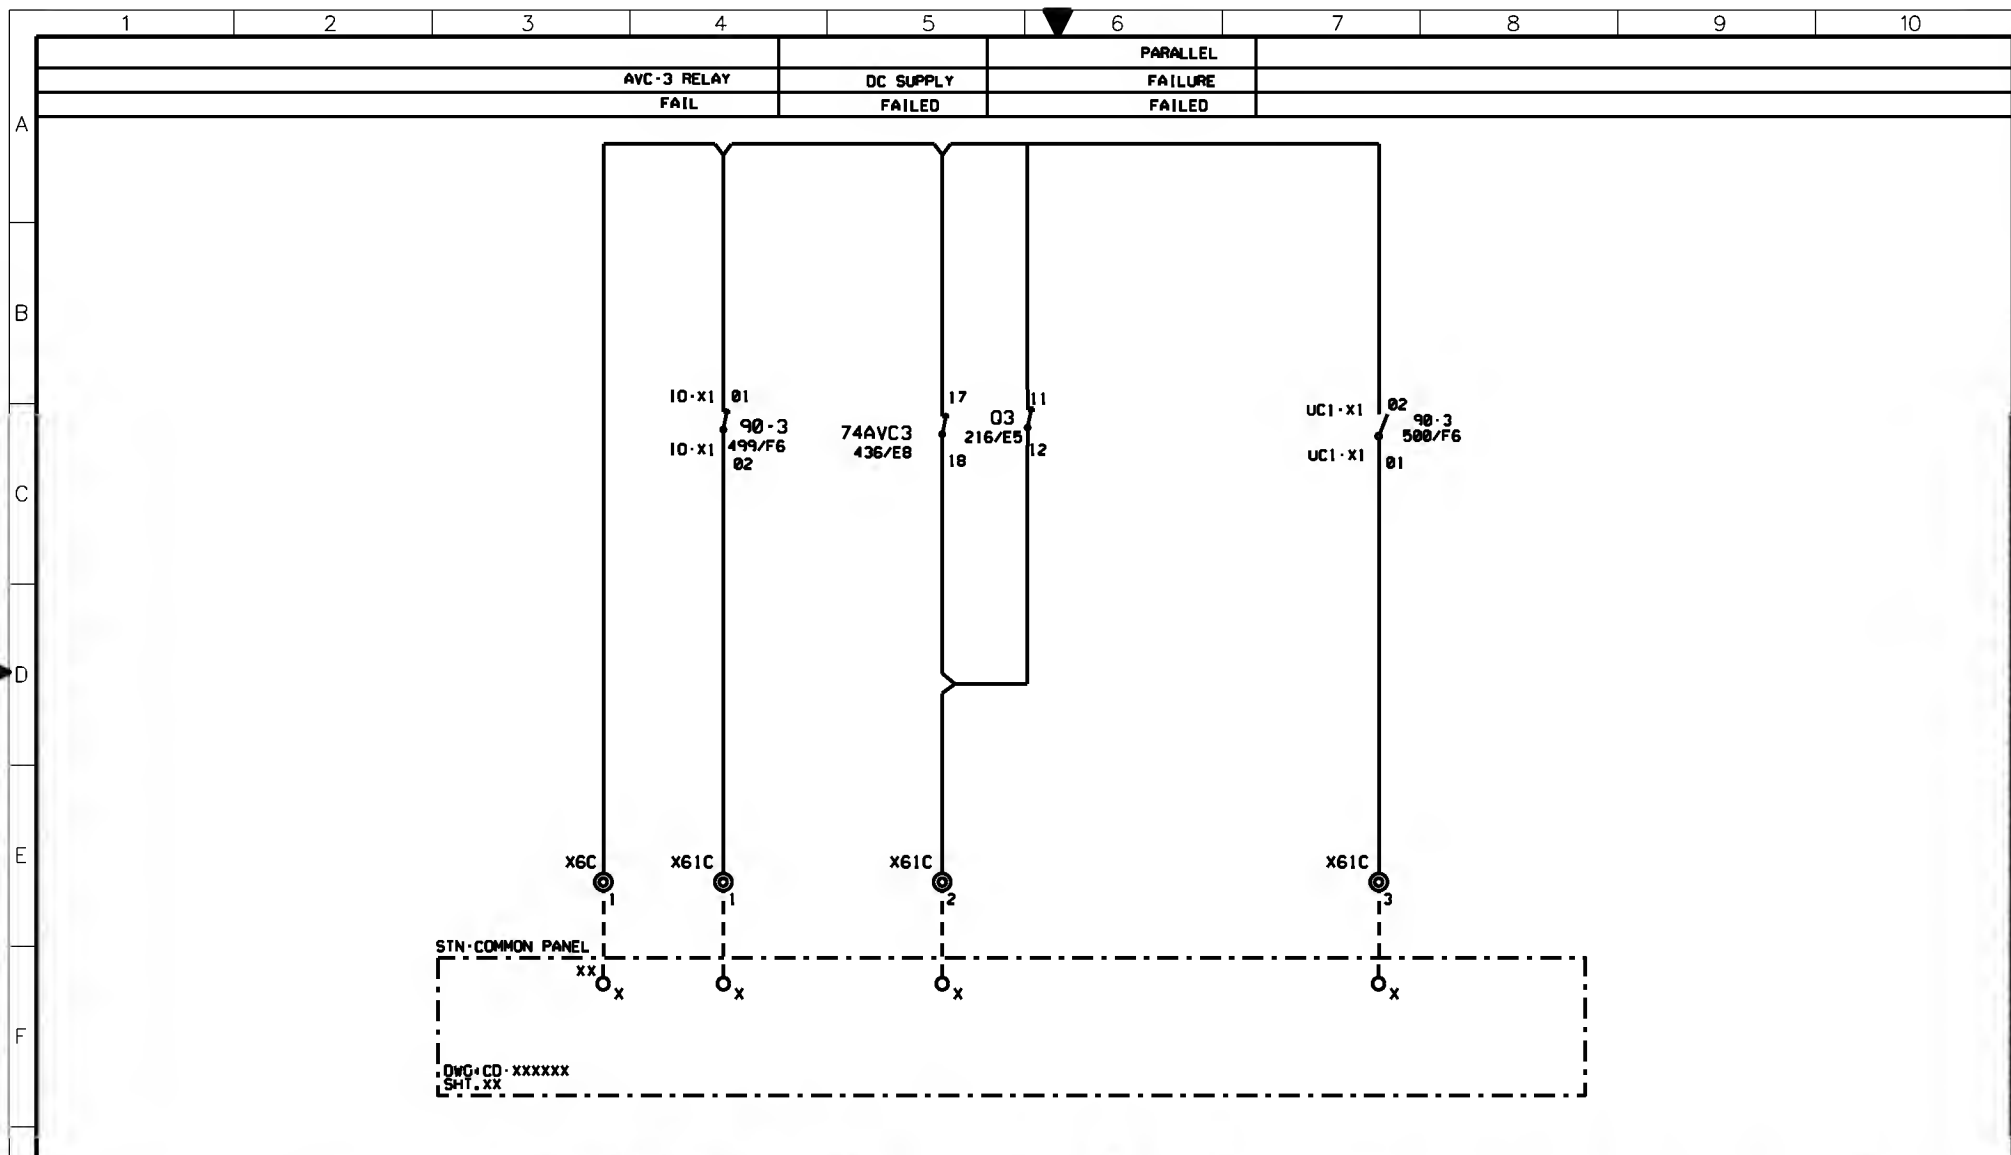

AS-BUILT BY _____			DATE _____		CONTRACT NO. 11131113/00		JOB ORDER NO. S-13020		STN-COMMON ALARM CIRCUIT			شركة الوطنية لنقل الكهرباء					نقل الكهرباء						
02			13 49		FACTORY ASBUILT		DRAWN BY RIZ		CHECKED BY JKR		132/13.8KV (GT1,GT2,GT3) AVC PANEL			INDEX		PLANT NO.		DRAWING NUMBER		SHEET NO.		REV. NO.	
01			13 25		AS PER SEC COMMENT		DATE STARTED 04.02.2013		DATE COMPLETED _____		S/S 8709 - 132/13.8KV IN AL-KHARJ CITY			-		C421		CD-322936		SHT CONT.		02	
00			13 06		FOR APPROVAL		OPRG. DEPT. CTPD		ENG. DEPT. AUT-PSAC		RIYADH SAUDI ARABIA									493 498			
REV. NO.			DATE		DESCRIPTION																		

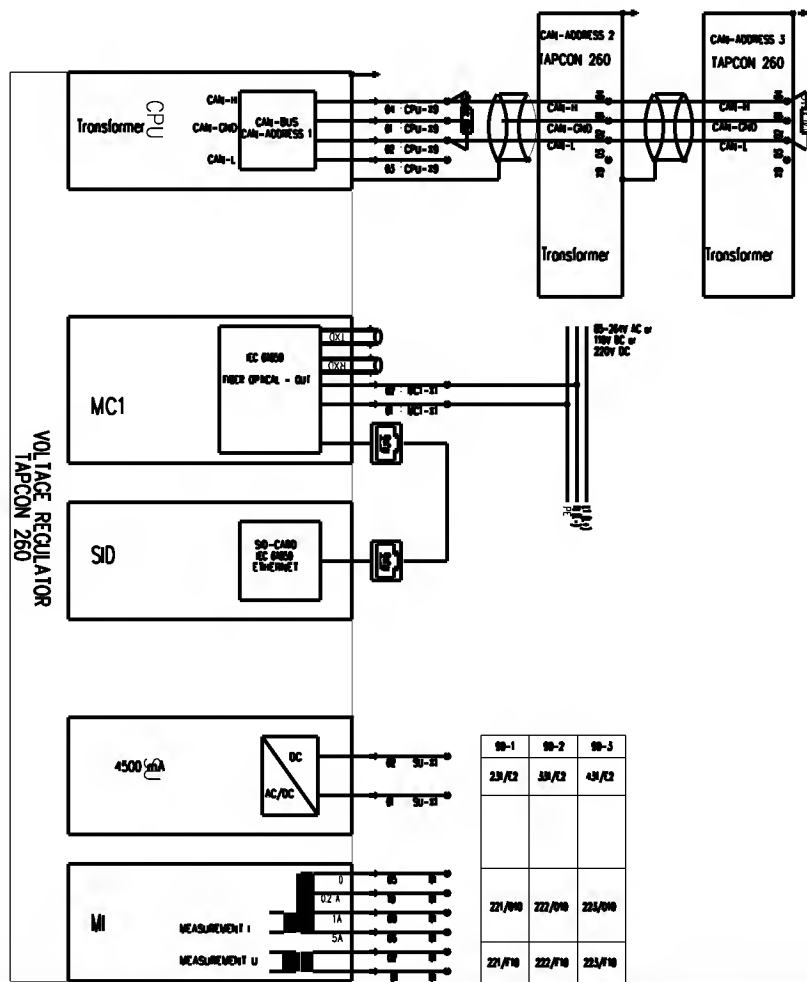

00-1	00-2	00-3
23/02	30/02	43/02
22/01/0	22/01/0	22/01/0
22/01/0	22/01/0	22/01/0

AS-BUILT BY _____ DATE _____ CONTRACT NO. **11131113/00** JOB ORDER NO. **S-13020**

02	13 49	FACTORY ASBUILT
01	13 25	AS PER SEC COMMENT
00	13 06	FOR APPROVAL


DRAWN BY **RIZ** CHECKED BY **JKR**
 DATE STARTED **04.02.2013** DATE COMPLETED _____
 OPRG. DEPT. **CTPD** ENG. DEPT. **AUT-PSAC**

AVR BLOCK DIAGRAM
132/13.8KV (GT1,GT2,GT3) AVC PANEL
S/S 8709 - 132/13.8KV IN AL-KHARJ CITY
RIYADH SAUDI ARABIA


الشركة الوطنية لنقل الكهرباء




INDEX	PLANT NO.	DRAWING NUMBER	SHEET NO.	REV. NO.
-	C421	CD-322936	498/499	02

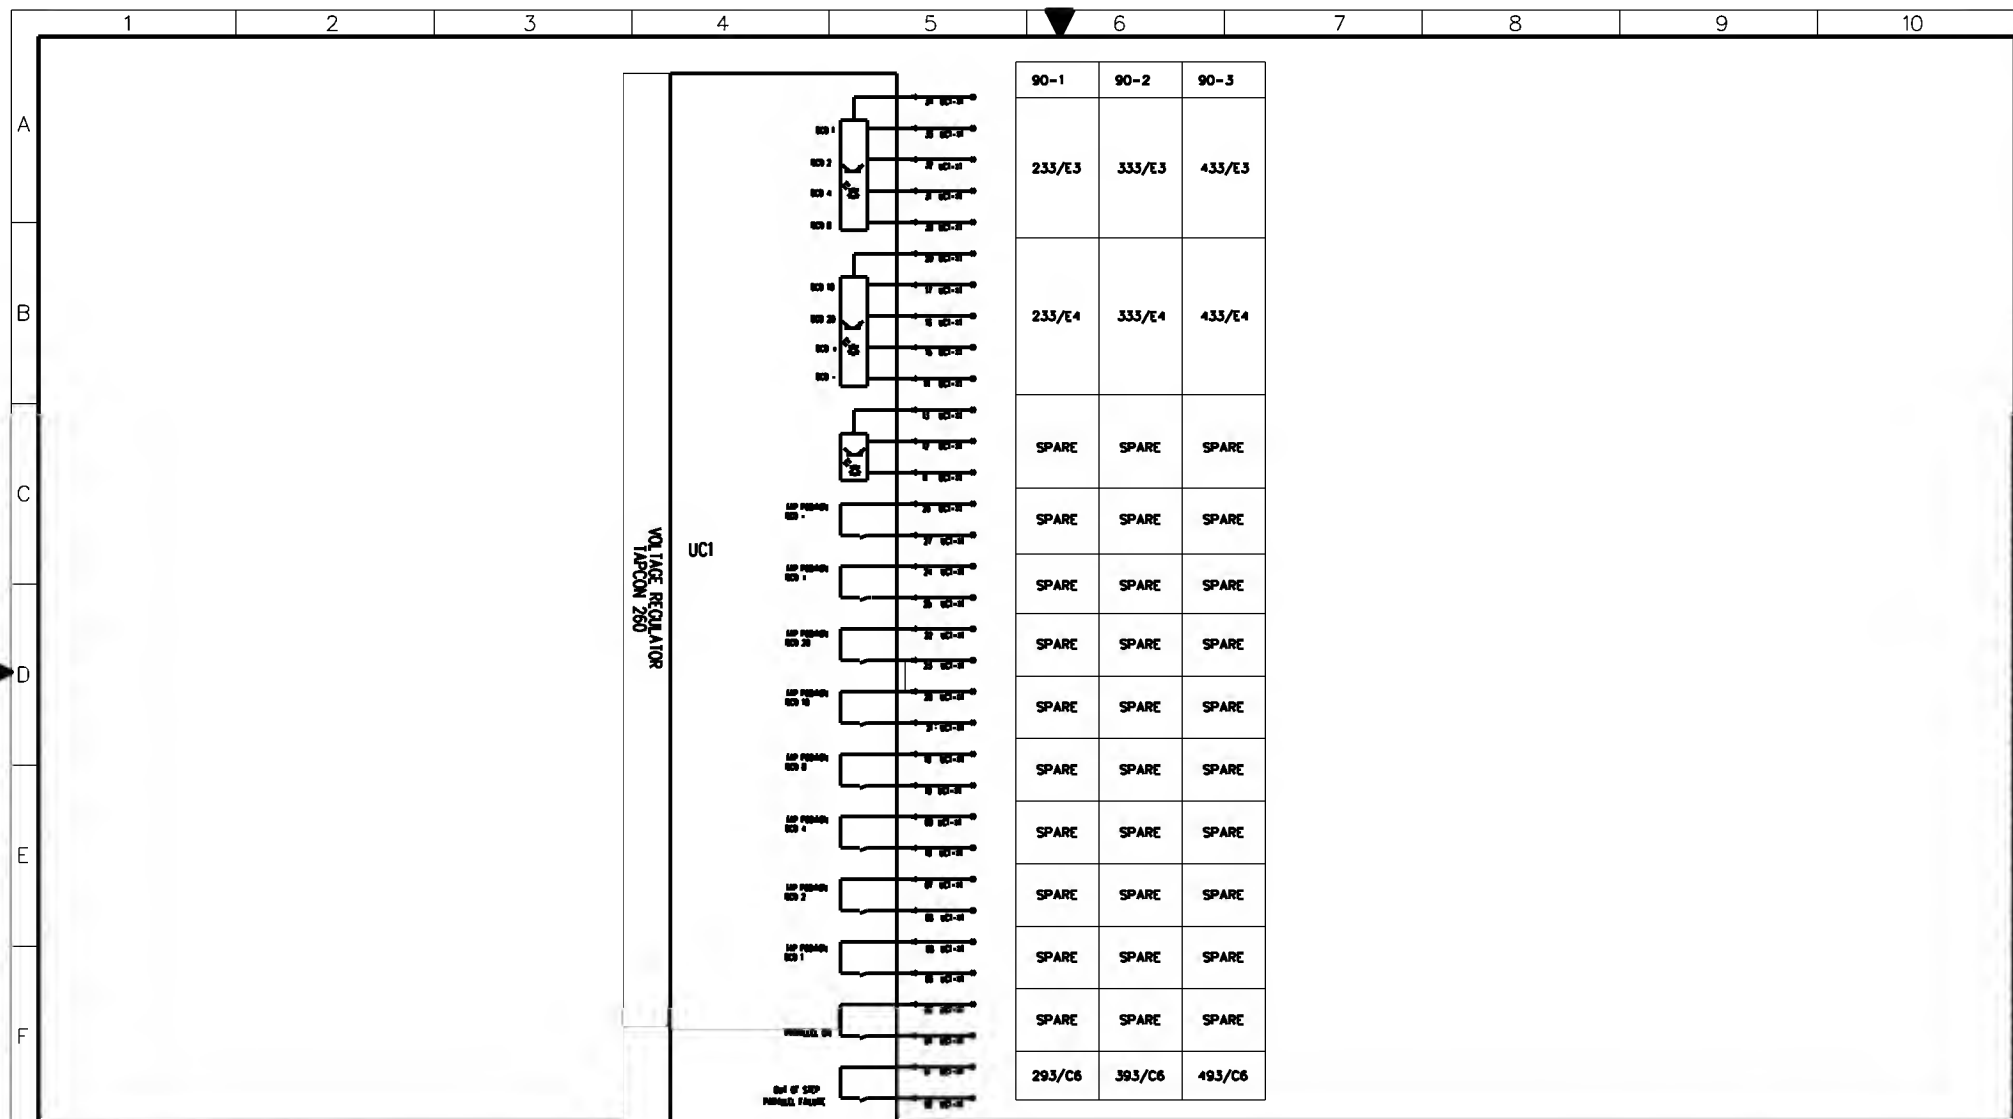


AS-BUILT BY _____ DATE _____		CONTRACT NO. 1113113/00	JOB ORDER NO. S-13020	AVR BLOCK DIAGRAM		نقل الكهرباء الشركة الوطنية لنقل الكهرباء National Grid sa	
02	13 49	FACTORY ASBUILT	DRAWN BY RIZ CHECKED BY JKR	132/13.8KV (GT1,GT2,GT3) AVC PANEL		INDEX	PLANT NO.
01	13 25	AS PER SEC COMMENT	DATE STARTED 04.02.2013 DATE COMPLETED _____	S/S 8709 - 132/13.8KV IN AL-KHARJ CITY		DRAWING NUMBER	SHEET NO.
00	13 06	FOR APPROVAL	OPRG. DEPT. CTPD ENG. DEPT. AUT-PSAC	RIYADH SAUDI ARABIA		CD-322936	500 501
REV. NO.	DATE	DESCRIPTION					REV. NO.
							02

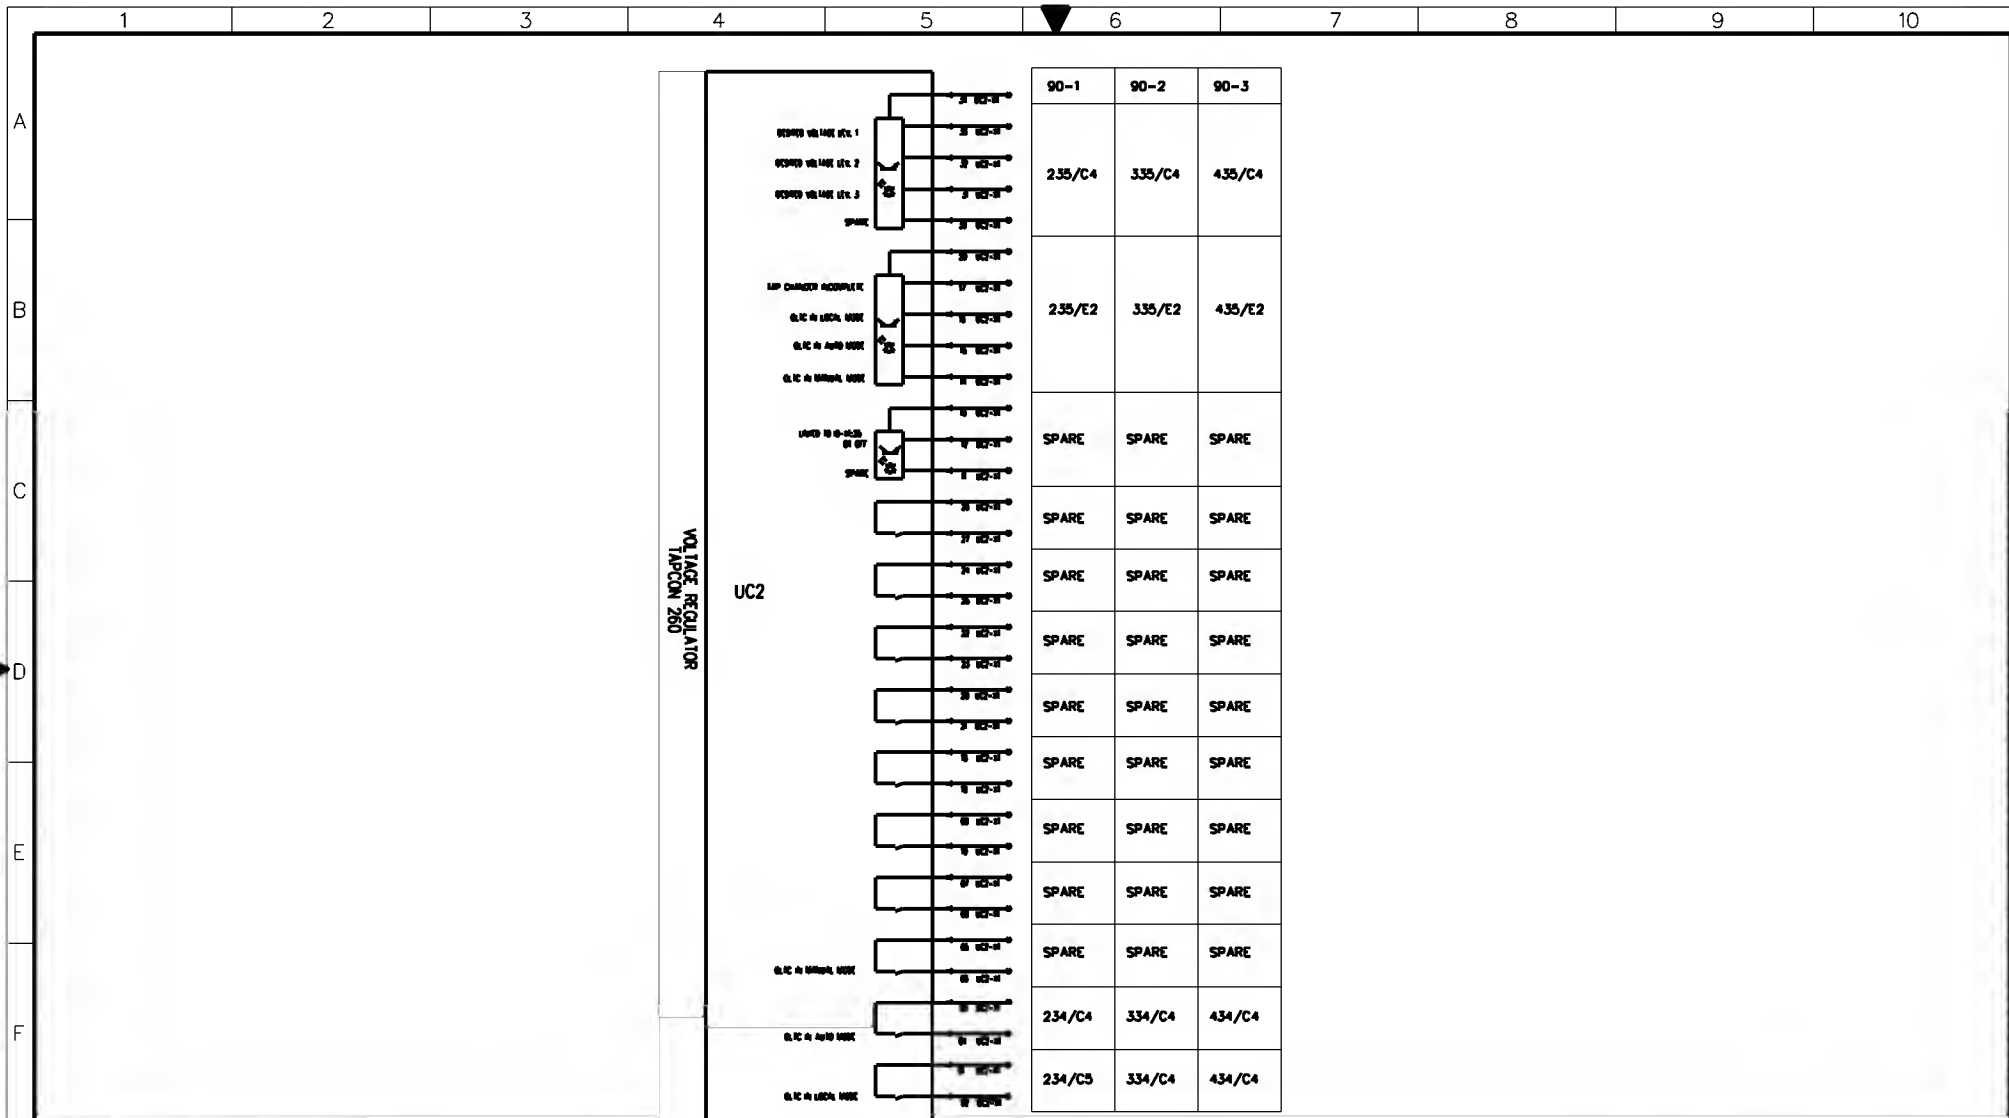

AS-BUILT BY _____ DATE _____		CONTRACT NO. 11131113/00	JOB ORDER NO. S-13020	AVR BLOCK DIAGRAM		الشركة الوطنية لنقل الكهرباء		نقل الكهرباء	
02	13 49	FACTORY ASBUILT		DRAWN BY RIZ CHECKED BY JKR		132/13.8KV (GT1,GT2,GT3) AVC PANEL		National Grid sa	
01	13 25	AS PER SEC COMMENT		DATE STARTED 04.02.2013 DATE COMPLETED _____		S/S 8709 - 132/13.8KV IN AL-KHARJ CITY		INDEX PLANT NO. DRAWING NUMBER SHEET NO. REV. NO.	
00	13 06	FOR APPROVAL		PRG. DEPT. CTPD ENG. DEPT. AUT-PSAC		RIYADH SAUDI ARABIA		- C421 CD-322936 501 502 02	
REV. NO.	DATE	DESCRIPTION							

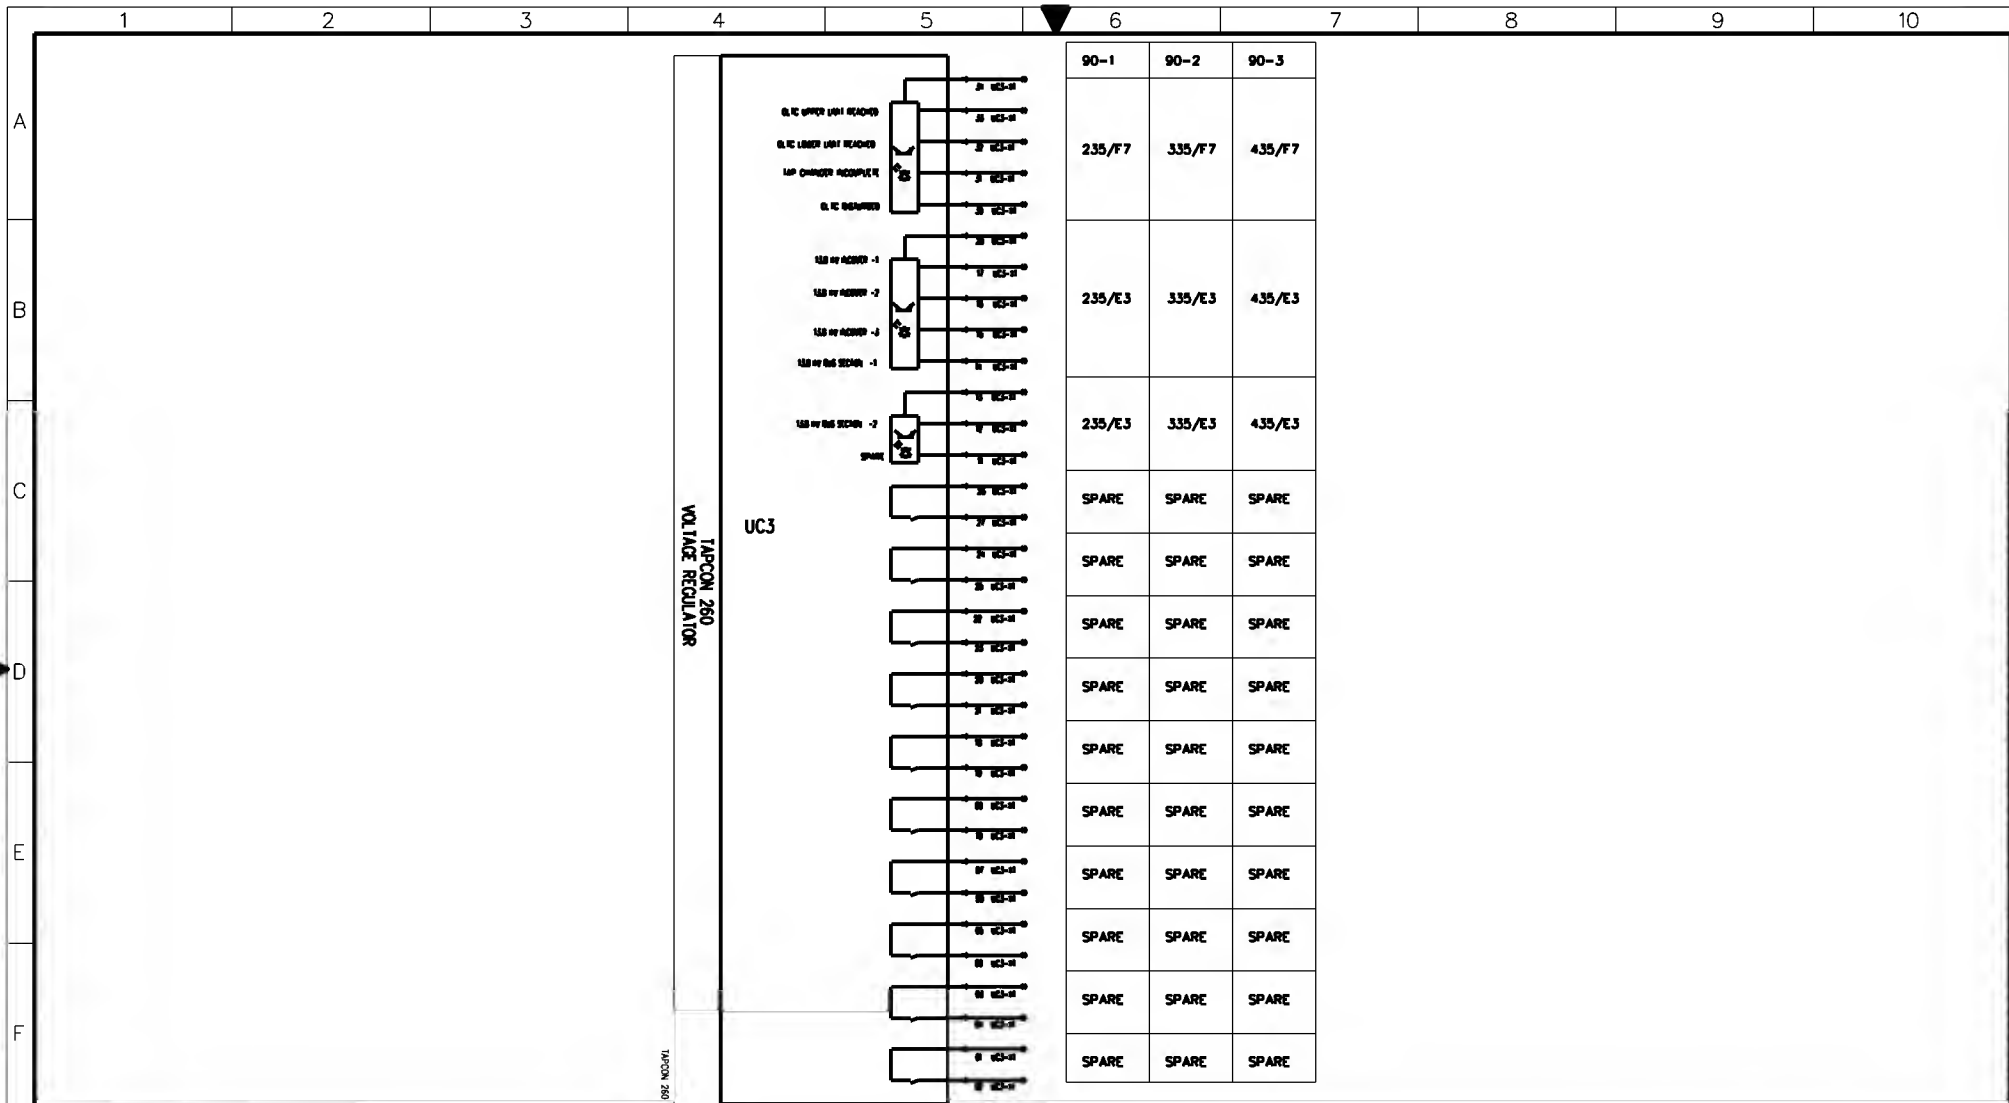

AS-BUILT BY _____ DATE _____			CONTRACT NO. 11131113/00		JOB ORDER NO. S-13020		AVR BLOCK DIAGRAM 132/13.8KV (GT1,GT2,GT3) AVC PANEL S/S 8709 - 132/13.8KV IN AL-KHARJ CITY RIYADH SAUDI ARABIA		نقل الكهرباء الشركة الوطنية لنقل الكهرباء National Grid sa	
02 13 49 FACTORY ASBUILT 01 13 25 AS PER SEC COMMENT 00 13 06 FOR APPROVAL			DRAWN BY RIZ CHECKED BY JKR DATE STARTED 04.02.2013 DATE COMPLETED _____ OPRG. DEPT. CTPD ENG. DEPT. AUT-PSAC		INDEX PLANT NO. DRAWING NUMBER SHEET NO. REV. NO. - C421 CD-322936 502 503 02					

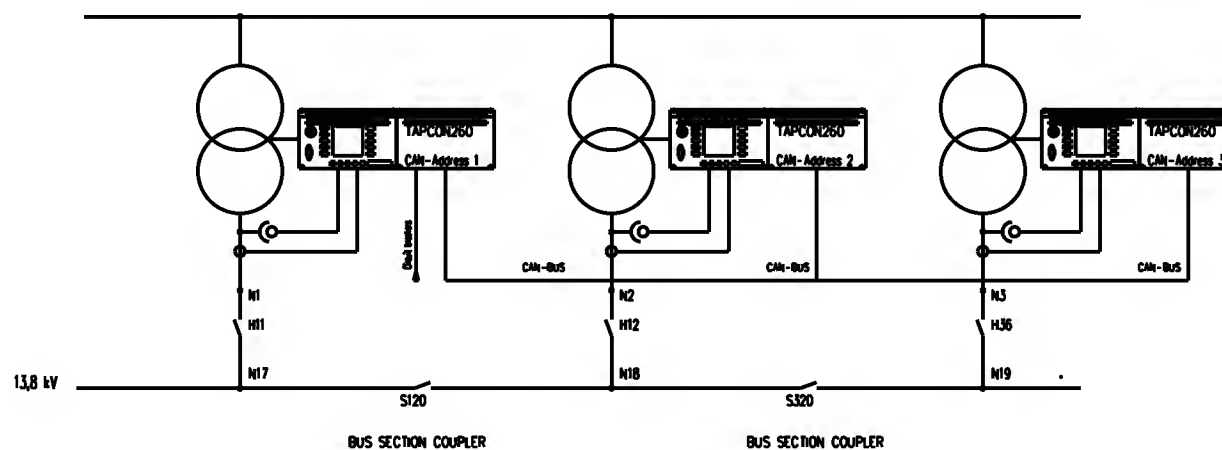

AS-BUILT BY _____ DATE _____ CONTRACT NO. **1113113/00** JOB ORDER NO. **S-13020**

02	13 49	FACTORY ASBUILT
01	13 25	AS PER SEC COMMENT
00	13 06	FOR APPROVAL
REV. NO.	DATE	DESCRIPTION

DRAWN BY **RIZ** CHECKED BY **JKR**
 DATE STARTED **04.02.2013** DATE COMPLETED _____
 OPRG. DEPT. **CTPD** ENG. DEPT. **AUT-PSAC**

AVR TOPOLOGY
132/13.8KV (GT1,GT2,GT3) AVC PANEL
S/S 8709 - 132/13.8KV IN AL-KHARJ CITY
RIYADH SAUDI ARABIA

الشركة الوطنية لنقل الكهرباء		نقل الكهرباء	
National Grid sa		National Grid sa	
INDEX	PLANT NO.	DRAWING NUMBER	SHEET NO.
-	C421	CD-322936	503504
			REV. NO.
			02

	1	2	3	4	5	6	7	8	9	10
A										
B										
C										
D										
E										
F										

REFERENCE	X3 AC CXTS.
211/A3	1 2 3 1
211/A7	2 2 3 2
211/A3	3 2 3 3
211/A7	4 2 3 4
211/B3	5 2 3 5
211/B7	6 2 3 6
211/B3	7 2 3 7
211/B7	8 2 3 8
SPARE	9 2 3 9
SPARE	10 2 3 10

REFERENCE	XD BLOCKING DIODE
234A/D4	1 2 3 1
234A/D4	2 2 3 2
334A/D4	3 2 3 3
334A/D4	4 2 3 4
434A/D4	5 2 3 5
434A/D4	6 2 3 6
SPARE	7 2 3 7

REFERENCE	XTJ TELEPHONE JACK
211/C3	1 2 3 1
211/C3	2 2 3 2
211/C3	3 2 3 3
211/D3	4 2 3 4
SPARE	5 2 3 5

REFERENCE	XSH SPACE HEATER
211/E6	1 2 3 1
211/F6	2 2 3 2
SPARE	3 2 3 3

REFERENCE	X6A ANNUAL CXTS.
212/B5	1 2 3 1
212/B5	2 2 3 2
212/C3	3 2 3 3
SPARE	4 2 3 4

REFERENCE	X6B ANNUAL CXTS.
303/E3	1 2 3 1
SPARE	2 2 3 2

REFERENCE	X6C ANNUAL CXTS.
403/E3	1 2 3 1
SPARE	2 2 3 2

AS-BUILT BY _____ DATE _____		CONTRACT NO. 11131113/00	JOB ORDER NO. S-13020	TERMINAL BLOCK REFERENCE		الشركة الوطنية لنقل الكهرباء		نقل الكهرباء	
02	13 49	FACTORY ASBUILT		DRAWN BY RIZ	CHECKED BY JKR	132/13.8KV (GT1,GT2,GT3) AVC PANEL		National Grid sa	
01	13 25	AS PER SEC COMMENT		DATE STARTED 04.02.2013 DATE COMPLETED _____		S/S 8709 - 132/13.8KV IN AL-KHARJ CITY		INDEX PLANT NO. DRAWING NUMBER SHEET NO. REV. NO.	
00	13 06	FOR APPROVAL		OPRG. DEPT. CTPD ENG. DEPT. AUT-PSAC		- C421 CD-322936 505 NIL 02		SHT CONT.	
REV. NO.	DATE	DESCRIPTION		RIYADH SAUDI ARABIA					